

MISSISSIPPI DEPARTMENT OF NATURAL RESOURCES

Bureau of Land and Water Resources

Southport Mall

P.O. Box 10631

Jackson, Mississippi 39209

WATER WELL DRILLERS LOG

MARSHALL
S 2031
11-6-81

11-6-81 date well completed Deaneffert 3rd Well firm name Marshall county well located

LANDOWNER:	description of formations encountered	from	to
Curtis Lester Waterford Miss. (mailing address)			
	Sand	25	170
WELL LOCATION:			
sec. 26 T. 5 N. R. 3 E. 4 miles South of Waterford (distance) (direction) (nearest town)			
WELL PURPOSE: <u>Drinking</u> (home, irrigation, municipal, industrial)			
WELL COMPLETION DATA:			
(1) diameter (inches) <u>4"</u>			
(2) total depth (feet) <u>170 feet</u>			
(3) static water level (feet) <u>115</u> below above top of ground.			
(4) casing <u>PVC</u> , <u>170 feet</u> (material) (depth)			
<u> </u> if telescope see back. (size)			
(5) screen <u>7ft</u> , <u>163 feet</u> (length) (depth to top)			
<u>4"</u> , <u>Gravel work</u> (size) (material)			
(6) pump <u>3/4</u> <u>84</u> (HP) (yield gpm)			
<u> </u> (type power)			
(7) electric log <u>Elect.</u> (yes or no)			
<u> </u> (organization running log)			
(8) how well bottom plugged <u>4' cap</u>			

DRILLERS REMARKS:


DEPT. OF NATURAL RESOURCES
BUREAU OF LAND & WATER RESOURCES

NOV 16 1981

RECEIVED

If well telescopes please
sketch and show depths.

GROUND LEVEL

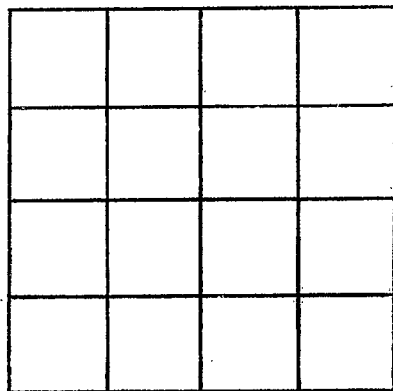

SECTION _____

Please indicate well location X.

ADDITIONAL INFORMATION

If more than one screen,
show locations of each on sketch.