

MISSISSIPPI DEPARTMENT OF NATURAL RESOURCES

Bureau of Land and Water Resources

Southport Mall

P.O. Box 10631

Jackson, Mississippi 39209

WATER WELL DRILLERS LOG

MARSHALL
S 2032
11-2-81

11-2 1981 date well completed
 Deont Kent Bunker firm name
 Marshall county well located

LANDOWNER:	description of formations encountered	from	to
Lela Jeffries Waterford, Miss. (mailing address)			
WELL LOCATION:			
sec. <u>35</u> <u>5</u> N. <u>3</u> E. 4 miles South of Waterford (distance) (direction) (nearest town)			
WELL PURPOSE: <u>Residential</u> (home, irrigation, municipal, industrial)			
WELL COMPLETION DATA:			
(1) diameter (inches) <u>4"</u>			
(2) total depth (feet) <u>87</u>			
(3) static water level (feet) <u>20</u> below above top of ground.			
(4) casing <u>PVC</u> , <u>87</u> , (material) (depth) (size) if telescope see back.			
(5) screen <u>7ft.</u> , <u>80</u> (length) (depth to top) <u>4"</u> , <u>gravel</u> (size) (material)			
(6) pump <u>3/4</u> , <u>14</u> (HP) (yield gpm) (type power)			
(7) electric log <u>Elect.</u> (yes or no) (organization running log)			
(8) how well bottom plugged <u>4' cob</u>			
DRILLERS REMARKS:			


DEPT. OF NATURAL RESOURCES
 BUREAU OF LAND & WATER RESOURCES

NOV 16 1981

RECEIVED

If well telescopes please sketch and show depths.

GROUND LEVEL

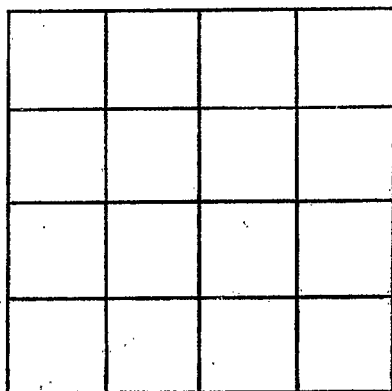

SECTION _____

Please indicate well location X.

ADDITIONAL INFORMATION

If more than one screen,
show locations of each on sketch.