

MISSISSIPPI DEPARTMENT OF NATURAL RESOURCES

Bureau of Land and Water Resources

Southport Mall

P.O. Box 10631

Jackson, Mississippi 39209

WATER WELL DRILLERS LOG

Marshall  
S 2033  
8-3-81

Aug 3 1981 R. R. Carpenter Marshall  
 date well completed firm name county well located

LANDOWNER:	description of formations encountered	from	to
<u>Old City Palace</u> <u>Waterford Miss.</u> <u>R.R.D.</u> (mailing address)			
WELL LOCATION: sec. <u>35</u> T. <u>5</u> N. R. <u>3</u> E. <u>3 1/2</u> miles <u>South</u> of <u>Waterford</u> (distance) (direction) (nearest town)	<u>Med Red Sand</u>	<u>18</u>	<u>35</u>
WELL PURPOSE: <u>Home</u> (home, irrigation, municipal, industrial)	<u>Med White Sand</u>	<u>35</u>	<u>70</u>
WELL COMPLETION DATA: (1) diameter (inches) <u>4</u> (2) total depth (feet) <u>140</u> (3) static water level (feet) <u>75</u> below above top of ground. (4) casing <u>PVC</u> , <u>130'</u> (material) (depth) (size) If telescope see back. (5) screen <u>10'</u> , <u>130'</u> (length) (depth to top) <u>4"</u> , <u>PVC</u> (size) (material) (6) pump <u>1/2</u> , <u>10</u> (HP) (yield gpm) <u>Elec.</u> (type power) (7) electric log <u>no</u> (yes or no) (organization running log) (8) how well bottom plugged <u>PVC cap</u>	<u>Fine White Sand + White Clay</u>	<u>70</u>	<u>93</u>
	<u>White Med Sand</u>	<u>93</u>	<u>150</u>
	<u>White Coarse Sand</u>	<u>120</u>	<u>140</u>

DEPT. OF NATURAL RESOURCES  
 BUREAU OF LAND & WATER RESOURCES


SEP 7 1987

RECEIVED

DRILLERS REMARKS:

If well telescopes please sketch and show depths.

GROUND LEVEL

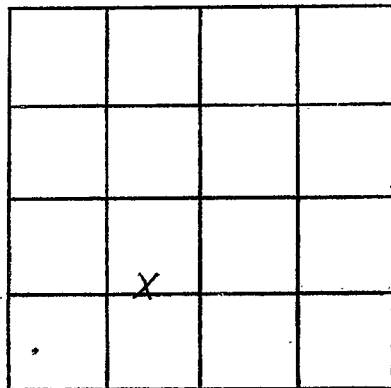

SECTION 35

Please indicate well location X.

ADDITIONAL INFORMATION

If more than one screen,  
show locations of each on sketch.