

MISSISSIPPI DEPARTMENT OF NATURAL RESOURCES
Bureau of Land and Water Resources
 Southport Mall
 P.O. Box 10631
 Jackson, Mississippi 39209
WATER WELL DRILLERS LOG

Marshall
S
S 2035

5/12 19 82
 date well completed

HICKS WELL COMPANY

Marshall

1 - BOX # 157 name

county well located

LANDOWNER: Wayne Daniels

MISS. description of formations encountered

from

to

Waterford, Miss.
 (mailing address)

Red Clay 0- 20

Red Sand 20 35

White Sand & Clay 35- 50

White Sand 50 180

WELL LOCATION:

sec. 14 T. 5 N R. 3 E
 S W

1 1/2 miles W of Waterford
 (distance) (direction) (nearest town)

WELL PURPOSE: home
 (home, irrigation, municipal, industrial)

WELL COMPLETION DATA:

(1) diameter (inches) 4
 (2) total depth (feet) 180
 (3) static water level (feet) 110 below above
 top of ground.

(4) casing PVE, 180
 (material) (depth)

 If telescope see back.
 (size)

(5) screen 10, 170
 (length) (depth to top)

0.10, pvc
 (size) (material)

(6) pump 1/2, 10
 (HP) (yield gpm)

220v
 (type power)

(7) electric log no
 (yes or no)

 (organization running log)

(8) how well bottom plugged cap

DEPT. OF NATURAL RESOURCES
 BUREAU OF LAND & WATER RESOURCES


JUN 14 1982

RECEIVED

DRILLERS REMARKS:

If well telescopes please sketch and show depths.

GROUND LEVEL

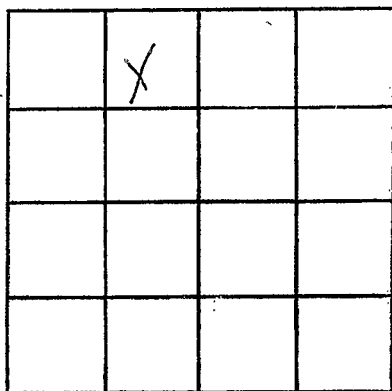

SECTION 14

Please indicate well location X.

ADDITIONAL INFORMATION

If more than one screen,
show locations of each on sketch.