

MISSISSIPPI DEPARTMENT OF NATURAL RESOURCES

Bureau of Land and Water Resources

Southport Mall

P.O. Box 10631

Jackson, Mississippi 39209

WATER WELL DRILLERS LOG

Marshall
S 2037

8-25
date well completed

1982 R. L. Carpenter
firm name

Marshall
county well located

LANDOWNER: Wayne Ryan

Waterford, ms

RFD
(mailing address)

description of formations encountered

from

to

Surface Soil 0 15

med white sand 15 40

white clay 40 65

white coarse sand 65 92

WELL LOCATION:

sec. 25 T. 5 N. R. 3 E. S. W
2 miles South of Waterford
(distance) (direction) (nearest town)

WELL PURPOSE: Home
(home, irrigation, municipal, industrial)

WELL COMPLETION DATA:

- (1) diameter (inches) 4
- (2) total depth (feet) 92
- (3) static water level (feet) 40 below above top of ground.
- (4) casing Plastic, 82'
(material) (depth)

 if telescope see back.
(size)

- (5) screen 10', 82'
(length) (depth to top)
4", PVC
(size) (material)

- (6) pump 1/2, 12
(HP) (yield gpm)
Elec.
(type power)

- (7) electric log no.
(yes or no)

(organization running log)

- (8) how well bottom plugged PVC Cap

DRILLERS REMARKS:


DEPT. OF NATURAL RESOURCES
BUREAU OF LAND & WATER RESOURCES

OCT 29 1984

RECEIVED

If well telescopes please sketch and show depths.

GROUND LEVEL

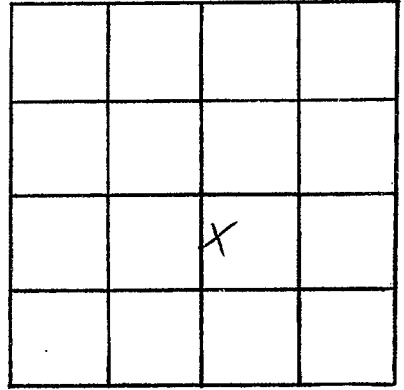

SECTION 25

Please indicate well location X.

ADDITIONAL INFORMATION

If more than one screen,
show locations of each on sketch.