

MISSISSIPPI DEPARTMENT OF NATURAL RESOURCES

Bureau of Land and Water Resources

Southport Mall

P.O. Box 10631

Jackson, Mississippi 39209

WATER WELL DRILLERS LOG

Marshall  
OS  
2038

HICKS WELL CO.

RT. 1, Box 157  
Senoia, MS 38660

Marshall  
County well located

2-15-83  
date well completed

LANDOWNER: Zadie Bowen  
Box 5 Box 230  
Holly Springs, Mo.  
(mailing address) 38635

description of formations encountered	from	to
<u>Red Clay</u>	<u>0</u>	<u>15</u>
<u>Red Sand &amp; Sand Rock</u>	<u>15</u>	<u>65</u>
<u>Red Sand</u>	<u>65</u>	<u>110</u>
<u>White Sand &amp; Clay</u>	<u>110</u>	<u>225</u>
<u>White Sand</u>	<u>225</u>	<u>310</u>

WELL LOCATION:  
sec. 10 T. S N. R. 3 E.  
3 miles E of Jalena  
(distance) (direction) (nearest town)

WELL PURPOSE: Home  
(home, irrigation, municipal, industrial)

WELL COMPLETION DATA:

- (1) diameter (inches) 4"
- (2) total depth (feet) 310'
- (3) static water level (feet) 276 <sup>below</sup> <sub>above</sub> top of ground.
- (4) casing PVC, 310'  
(material) (depth)  
4"  
(size) If telescope see back.
- (5) screen 10', 300'  
(length) (depth to top)  
013, PVC  
(size) (material)
- (6) pump 3/4, 10  
(HP) (yield gpm)  
220V  
(type power)
- (7) electric log No  
(yes or no)  
  
(organization running log)
- (8) how well bottom plugged Cap

DEPT. OF NATURAL RESOURCES  
BUREAU OF LAND & WATER RESOURCES


MAR 28 1983

RECEIVED

DRILLERS REMARKS:

If well telescopes please sketch and show depths.

GROUND LEVEL

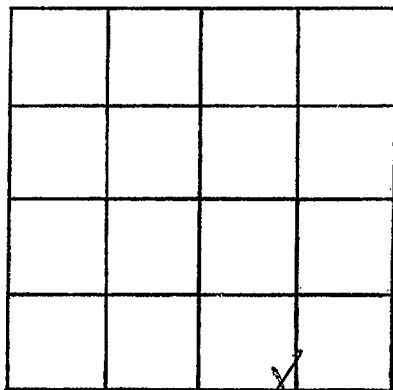

SECTION 10

Please indicate well location X.

ADDITIONAL INFORMATION

If more than one screen,  
show locations of each on sketch.