

MISSISSIPPI DEPARTMENT OF NATURAL RESOURCES
Bureau of Land and Water Resources
 Southport Mall
 P.O. Box 10631
 Jackson, Mississippi 39209
WATER WELL DRILLERS LOG

Marshall
SS
2041

8-3 19 83 Wilson Well Co Inc Marshall
 date well completed firm name county well located

LANDOWNER: Mandie Lee Jones
Rt 1 Box 162
Waterford, Ms.
 (mailing address)

description of formations encountered	from	to
<u>Red Clay - Red Sand</u>	<u>0</u>	<u>30</u>
<u>Red Sand - white clay</u>	<u>30</u>	<u>60</u>
<u>white clay - red sand</u>	<u>60</u>	<u>90</u>
<u>Red Sand</u>	<u>90</u>	<u>135</u>
<u>white clay - white sand</u>	<u>135</u>	<u>165</u>
<u>Brown sand</u>	<u>165</u>	<u>192</u>

WELL LOCATION:
 sec 26 T 5 N R 3 E
3 miles S of Waterford
 (distance) (direction) (nearest town)

WELL PURPOSE:
 (home, irrigation, municipal, industrial)

- WELL COMPLETION DATA:
- (1) diameter (inches) 4"
 - (2) total depth (feet) 192
 - (3) static water level (feet) 95 below above top of ground.
 - (4) casing 4 (material), 192 (depth),
4 (size) If telescope see back.
 - (5) screen 10 (length), (depth to top)
4 (size), Plastic (material)
 - (6) pump 3/4 (HP), 8 (yield gpm)
Electric (type power)
 - (7) electric log No (yes or no)
 (organization running log)
 - (8) how well bottom plugged 4"
Plastic cap

DRILLERS REMARKS:


DEPT. OF NATURAL RESOURCES
 BUREAU OF LAND & WATER RESOURCES

SEP 19 1983

RECEIVED

If well telescopes please sketch and show depths.

GROUND LEVEL

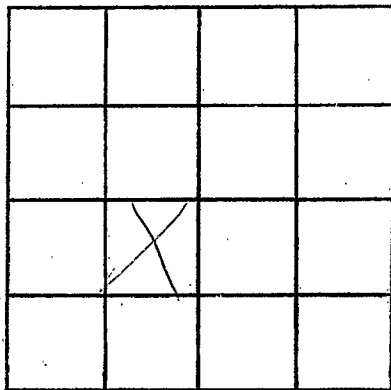

SECTION 26

Please indicate well location X.

ADDITIONAL INFORMATION

If more than one screen, show locations of each on sketch.