

**MISSISSIPPI DEPARTMENT OF NATURAL RESOURCES**  
**Bureau of Land and Water Resources**  
 Southport Mall  
 P.O. Box 10631  
 Jackson, Mississippi 39209  
**WATER WELL DRILLERS LOG**

Marshall  
S  
2042

10-19 1983 Wilson Well Co. Inc Marshall  
 date well completed firm name county well located

LANDOWNER: Marion Marshall  
Box 197-A  
Waterford MS  
 (mailing address)

description of formations encountered	from	to
<u>Brown Clay</u>	<u>0</u>	<u>10</u>
<u>White Red Sand-Clay</u>	<u>10</u>	<u>130</u>

WELL LOCATION:  
 sec. 36 T S N 3 R 3 E  
8 miles S of Waterford  
 (distance) (direction) (nearest town)

WELL PURPOSE: Home  
 (home, irrigation, municipal, industrial)

**WELL COMPLETION DATA:**

- (1) diameter (inches) 4
- (2) total depth (feet) 130
- (3) static water level (feet) 75 below above top of ground.
- (4) casing plastic, 130  
 (material) (depth)  
4 if telescope see back.  
 (size)
- (5) screen 1.0, 130  
 (length) (depth to top)  
4, plastic  
 (size) (material)
- (6) pump 3/4 9  
 (HP) (yield gpm)  
Electric  
 (type power)
- (7) electric log No  
 (yes or no)

(organization running log)  
 (8) how well bottom plugged 4-PVL  
CAP

DRILLERS REMARKS:


DEPT. OF NATURAL RESOURCES  
 BUREAU OF LAND & WATER RESOURCES

DEC 19 1983

**RECEIVED**

If well telescopes please sketch and show depths.

GROUND LEVEL

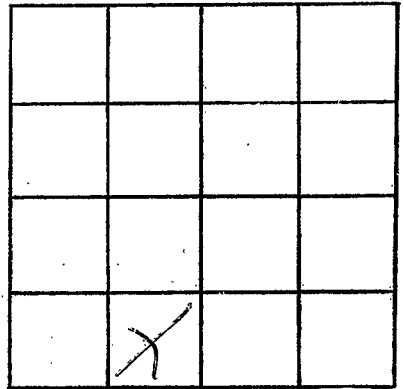

SECTION 36.

Please indicate well location X.

ADDITIONAL INFORMATION

If more than one screen,  
show locations of each on sketch.