

MISSISSIPPI DEPARTMENT OF NATURAL RESOURCES

Bureau of Land and Water Resources

Southport Mall

P.O. Box 10631

Jackson, Mississippi 39209

WATER WELL DRILLERS LOG

Marshall
5 S
2043

7-6 1984
 date well completed

HICKS WELL CO.

Marshall
 county well located

LANDOWNER: Mertha T. Mills
Rt. 3 Box #29
Waterford, Ms. 38685
 (mailing address)

description of formations encountered

from to

WELL LOCATION:
 sec. 31 T 5 N R 3 E
2 miles NE at Louis Hill
 (distance) (direction) (nearest town)

Red clay 0 20
Red sand 20 50

white sand + clay 50 165
white sand 165 195

WELL PURPOSE: Home
 (home, irrigation, municipal, industrial)

WELL COMPLETION DATA:

- (1) diameter (inches) 4
- (2) total depth (feet) 195
- (3) static water level (feet) 140 ^{below} _{above} top of ground.
- (4) casing PVC (material), (depth)
4" (size) If telescope see back.
- (5) screen 10 (length), 185' (depth to top)
.010 (size), PVC (material)
- (6) pump 3/4 (HP), 10 (yield gpm)
220V (type power)
- (7) electric log. No (yes or no)
 (organization running log)
- (8) how well bottom plugged Cap


DRILLERS REMARKS:

DEPT. OF NATURAL RESOURCES
 BUREAU OF LAND & WATER RESOURCES

RECEIVED
 SEP 24 1984

If well telescopes please sketch and show depths.

GROUND LEVEL

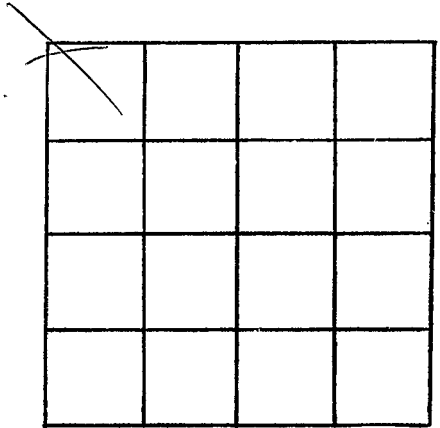

SECTION 31

Please indicate well location X.

ADDITIONAL INFORMATION

If more than one screen, show locations of each on sketch.