

MISSISSIPPI DEPARTMENT OF NATURAL RESOURCES

Bureau of Land and Water Resources

Southport Mall

P.O. Box 10631

Jackson, Mississippi 39209

WATER WELL DRILLERS LOG

Marshall
5
2044

4/25 1984
 date well completed

HICKS WELL CO.
 P.O. Box 157
 Senatobia, MS 38668

Marshall
 county well located

LANDOWNER: Bill Fitch
c/o 1st National Loans
Holly Springs, Ms. 38635
 (mailing address)

description of formations encountered	from	to
<u>Red Clay</u>	<u>0</u>	<u>20</u>
<u>Red Sand</u>	<u>20</u>	<u>50</u>
<u>Red + white sand</u>	<u>50</u>	<u>100</u>
<u>white sand</u>	<u>100</u>	<u>260</u>

WELL LOCATION:
 sec. 18 T 5 N R 3 E
1 miles S of Dalava
 (distance) (direction) (nearest town)

WELL PURPOSE: Home
 (home, irrigation, municipal, industrial)

- WELL COMPLETION DATA:
- (1) diameter (inches) 4
 - (2) total depth (feet) 260
 - (3) static water level (feet) 220 ^{below} above top of ground.
 - (4) casing PVC, 260,
 (material) (depth)
4'' if telescope see back.
 (size)
 - (5) screen 10', 250
 (length) (depth to top)
10'' PVC
 (size) (material)
 - (6) pump 3/4 10
 (HP) (yield gpm)
22.01
 (type power)
 - (7) electric log No
 (yes or no)
 (organization running log)
 - (8) how well bottom plugged Cap

DRILLERS REMARKS:


DEPT. OF NATURAL RESOURCES
 BUREAU OF LAND & WATER RESOURCES

MAY - 9 1984

RECEIVED

If well telescopes please sketch and show depths.

GROUND LEVEL

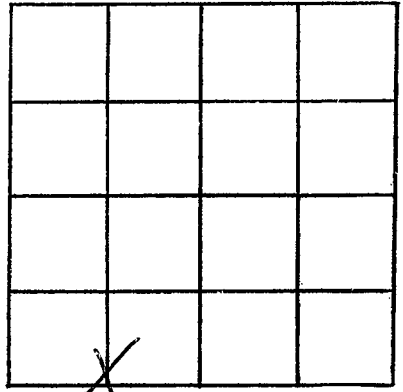

SECTION 18

Please indicate well location X.

ADDITIONAL INFORMATION

A series of horizontal lines for entering additional information.



If more than one screen, show locations of each on sketch.