

MISSISSIPPI DEPARTMENT OF NATURAL RESOURCES

Bureau of Land and Water Resources

Southport Mall

P.O. Box 10631

Jackson, Mississippi 39209

WATER WELL DRILLERS LOG

MARSHALL  
S 2045

HICKS WELL CO.  
P.O. Box 157  
Senatobia, MS 38668

Marshall  
county well located

5/25 19 84  
date well completed

LANDOWNER: Tommy Jiggins  
Rt. 5  
Holly Springs, Ms 38635  
(mailing address)

description of formations encountered	from to	
Red clay	0	15
Red sand	15	60
white sand	60	215

WELL LOCATION:  
sec. 11 T 5 N R 3 E  
2 miles W of Watuland  
(distance) (direction) (nearest town)

WELL PURPOSE: Home  
(home, irrigation, municipal, industrial)

- WELL COMPLETION DATA:
- (1) diameter (inches) 4
  - (2) total depth (feet) 215
  - (3) static water level (feet) 130 <sup>below</sup> top of ground.
  - (4) casing PVC, 215' (material), (depth)  
4" (size) if telescope see back.
  - (5) screen 10' (length), 205' (depth to top)  
.010" (size), PVC (material)
  - (6) pump 3/4 (HP), 10 (yield gpm)  
220V (type power)
  - (7) electric log No (yes or no)
  - (8) how well bottom plugged Cap

DRILLERS REMARKS:


DEPT. OF NATURAL RESOURCES  
BUREAU OF LAND & WATER RESOURCES

JUL 10 1984

RECEIVED

If well telescopes please sketch and show depths.

GROUND LEVEL

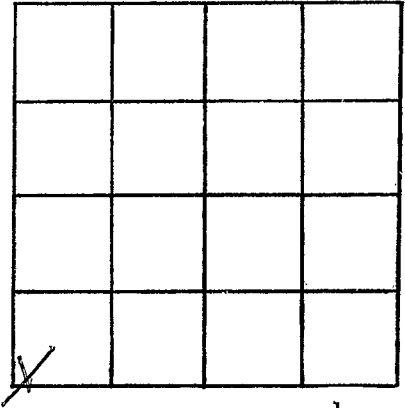

SECTION 11

Please indicate well location X.

ADDITIONAL INFORMATION

If more than one screen, show locations of each on sketch.