

Marshall
S 2046
6-10-85

MISSISSIPPI DEPARTMENT OF NATURAL RESOURCES
Bureau of Land and Water Resources
Southport Mall
P.O. Box 10631
Jackson, Mississippi 39209
WATER WELL DRILLERS LOG

6-10 date well completed 1985 Gullett Water Well firm name Marshall county well located

LANDOWNER: Porter, A. J.
Rt. 2 Box 90
Waterford, Ms 38685
(mailing address)

WELL LOCATION:
sec. 3 T 5 N R 3 E
2 miles North E of Waterford
(distance) (direction) (nearest town)

WELL PURPOSE: Home
(home, irrigation, municipal, industrial)

- WELL COMPLETION DATA:
- (1) diameter (inches) 4"
 - (2) total depth (feet) 110'
 - (3) static water level (feet) 60' below top of ground.
 - (4) casing 150' (material), 100' (depth)
4" (size) if telescope see back.
 - (5) screen 10ft (length), 100' (depth to top)
4" (size), 1120 PVC (material)
 - (6) pump 3/4 (HP), 10 (yield gpm)
(type power)
 - (7) electric log (yes or no)
(organization running log)
 - (8) how well bottom plugged Cap

description of formations encountered	from	to
top soil	0	5
clay	5	30
sand and clay	30	80
white sand	80	110


RECEIVED
JUN 17 1985

DRILLERS REMARKS:

Department of Natural Resources
Bureau of Land & Water Resources

If well telescopes please sketch and show depths.

GROUND LEVEL

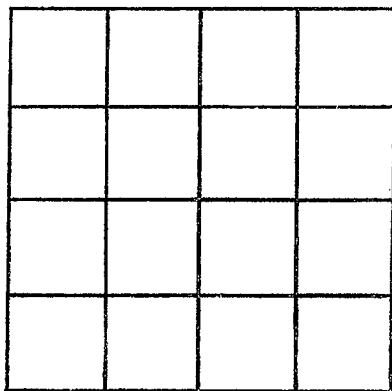

SECTION _____

Please indicate well location X.

ADDITIONAL INFORMATION

If more than one screen, show locations of each on sketch.