

MISSISSIPPI DEPARTMENT OF NATURAL RESOURCES
 Bureau of Land and Water Resources
 Southport Mall
 P.O. Box 10631
 Jackson, Mississippi 39209
WATER WELL DRILLERS LOG

MARSHALL
52049

9-4 date well completed 19 85 Larry Casartella's Marshall firm name county well located

LANDOWNER: Mary Prude
Waterford Ms.
R.F.D.
 (mailing address)


description of formations encountered	from	to
<u>Surface Soil</u>	<u>0</u>	<u>15</u>
74'		
<u>Coarse Red Sand</u>	<u>15</u>	<u>30</u>
<u>Med White Sand</u>	<u>30</u>	<u>50</u>
<u>White Coarse Sand</u>	<u>50</u>	<u>80</u>

WELL LOCATION:
 sec. 35 T. 5 N R. 3 E W
4 miles South of Waterford
 (distance) (direction) (nearest town)

WELL PURPOSE: Home
 (home, irrigation, municipal, industrial)

WELL COMPLETION DATA:

- (1) diameter (inches) 4
- (2) total depth (feet) 80'
- (3) static water level (feet) 45' below top of ground.
- (4) casing PVC, 70',
 (material) (depth)
 (size) if telescope see back.
- (5) screen 10', 70
 (length) (depth to top)
4", PVC
 (size) (material)
- (6) pump 1/2, 10
 (HP) (yield gpm)
Flu
 (type power)
- (7) electric log no
 (yes or no)
 (organization running log)
- (8) how well bottom plugged PVC cap

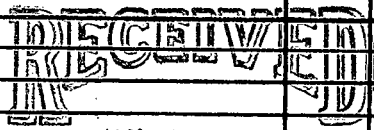


JUL 23 1986

Department of Natural Resources
 Bureau of Land & Water Resources

DRILLERS REMARKS:

If well telescopes please sketch and show depths.

GROUND LEVEL

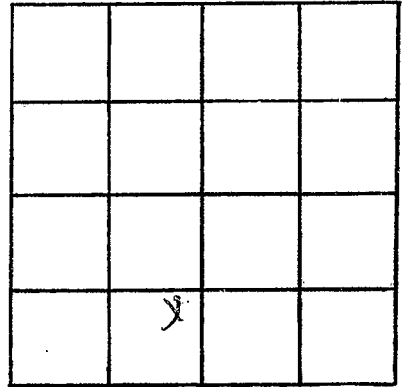

SECTION 35

Please indicate well location X.

ADDITIONAL INFORMATION

If more than one screen,
show locations of each on sketch.