

MARSHALL
S 2050

MISSISSIPPI DEPARTMENT OF NATURAL RESOURCES
Bureau of Land and Water Resources
Southport Mall
P.O. Box 10631

Jackson, Mississippi 39209
WATER WELL DRILLERS LOG

4-19
date well completed

1986 Shelton Water Well
firm name

Marshall
county well located

LANDOWNER: Jose League
4244 Baylin Ave
Memphis, TN 38108
(mailing address)

description of formations encountered

	from	to
<u>Top soil</u>	<u>0'</u>	<u>5'</u>
<u>Red clay</u>	<u>5'</u>	<u>20'</u>
<u>Red sand & clay</u>	<u>20'</u>	<u>60'</u>
<u>White sand & clay</u>	<u>60'</u>	<u>170'</u>
<u>White sand</u>	<u>170'</u>	<u>215'</u>

WELL LOCATION:

sec. 10 T. 5 N. R. 3 E.
6 miles West of Waterford
(distance) (direction) (nearest town)

WELL PURPOSE: Home
(home, irrigation, municipal, industrial)


WELL COMPLETION DATA:

- (1) diameter (inches) 4"
- (2) total depth (feet) 215
- (3) static water level (feet) 165' below above top of ground.
- (4) casing PVC, 205',
(material) (depth)
4" if telescope see back.
(size)
- (5) screen 10, 205',
(length) (depth to top)
4", PVC
(size) (material)
- (6) pump 3/4, 10
(HP) (yield gpm)
Elec
(type power)
- (7) electric log No
(yes or no)

(organization running log)

(8) how well bottom plugged Cap

DRILLERS REMARKS:

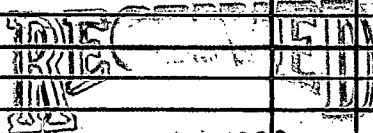


AUG 11 1986

Department of Natural Resources
Bureau of Land & Water Resources

If well telescopes please sketch and show depths.

GROUND LEVEL

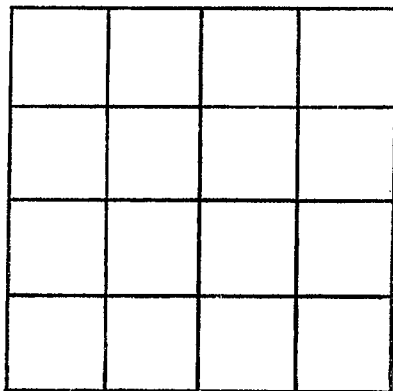

SECTION _____

Please indicate well location X.

ADDITIONAL INFORMATION

If more than one screen, show locations of each on sketch.