

# MISSISSIPPI DEPARTMENT OF NATURAL RESOURCES

Bureau of Land and Water Resources

COUNTY WELL LOCATED  
**MA05191**

WELL NUMBER CODED  
**S 2057**

DATE WELL COMPLETED  
**7-31-86**

PERMIT NUMBER

NAME OF DRILLING FIRM  
**Hicks Well Co**

**Senatobia, MS.**

P.O. Box 10631  
Jackson, Mississippi 39209  
WATER WELL DRILLERS LOG

NAME & MAILING ADDRESS OF LANDOWNER  
**Older Mosley**

**RT. 5**

**Holly Springs, MS.**

WELL LOCATION: SEC TOWNSHIP RANGE  
**15 5 N S 3 E**

DISTANCE DIRECTION NEAREST TOWN  
**3** Miles **WEST** of **Waterford**

OTHER LANDMARK

WELL PURPOSE (Home) Irrigation, Municipal, Industrial, Fish Pond, etc.

**PUMP DATA**

PUMP TYPE (Circle One):  
 Submersible Turbine Jet Flowing Well,  
Other (Describe) \_\_\_\_\_

POWER TYPE (Circle One):  
 Electric Tractor Diesel Gasoline Butane,  
Other (Describe) \_\_\_\_\_

Pump Capacity (GPM)	No. of Stages	Setting Depth
<b>10</b>	<b>10</b>	<b>140</b> FT.

PUMP TEST

Well yielded **10** GPM with  
a drawdown of **1** ft.  
after \_\_\_\_\_ hours of pumping

**WELL DATA**

Well Depth <b>180</b>	Casing Diameter (In.) <b>4"</b>	Casing Length (Ft.) <b>170</b>
Type of Casing <b>PVC</b>	Hole Depth <b>180</b>	Depth to Static Water Level <b>130</b>

TYPE OF COMPLETION: (Circle One or More):  
 Gravel Packed Underreamed, Telescoped,  
Natural Development, Open Hole, Other  
(Describe) \_\_\_\_\_

Top of Lap Pipe or Reduction in Casing  
**FEET** IF TELESCOPED OR MORE THAN ONE SCREEN: USE BACK PAGE

**LOG DATA**

TYPE OF LOG RUN (Circle One): No Log Run, Electric, Gamma Ray, Density, Sonic, Neutron, Other (Describe) \_\_\_\_\_

Name of Organization Running Log

**SCREEN DATA**

Diameter - Inches <b>4"</b>	Length - Feet <b>10</b>	Slot Size - Inches <b>0.13</b>
Screen Type <b>PVC slotted</b>	Depth to Bottom - Feet <b>10</b>	

**GEOLOGIC DATA (Office Use Only)**

Surface Elev.	Geologic Unit	Unit Thickness	Depth to Top
Subs. SWL	Date	Analysis	Aquifer Test

Driller's Remarks

DESCRIPTION OF FORMATIONS ENCOUNTERED	FROM	TO
<b>R.C.</b>	<b>0</b>	<b>20</b>
<b>R.S.</b>	<b>20</b>	<b>140</b>
<b>W.S.</b>	<b>140</b>	<b>180</b>

RECEIVED


SEP 05 1986

Department of Natural Resources  
Bureau of Land & Water Resources

IF MORE SPACE IS NEEDED, USE BACK

If well telescopes please sketch and show depths.

GROUND LEVEL

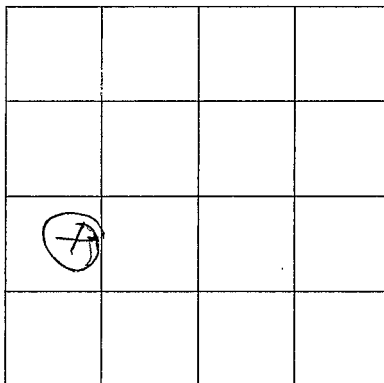

SECTION \_\_\_\_\_

Please indicate well location X.

ADDITIONAL INFORMATION

If more than one screen,  
show location of each on sketch.