

CODED

MISSISSIPPI  
BOARD OF WATER COMMISSIONERS  
416 North State Street  
Jackson, Mississippi 39201

CODED

WATER WELL DRILLERS LOG

MARSHALL
T 4
10-28-68
10-29-68
date well completed

*Athenian & Frost*      *Marshall*  
 firm name      county well located

LANDOWNER:  
*Richard and Nayland*  
*Wadsworth Miss*  
 (mailing address)

description of formations encountered	depth	
	from	to
<i>Red Clay</i>	<i>0</i>	<i>15</i>
<i>Red sandstone</i>	<i>15</i>	<i>30</i>
<i>White clay</i>	<i>30</i>	<i>70</i>
<i>White sandstone</i>	<i>70</i>	<i>100</i>

WELL LOCATION:  
 sec. 5 T. 5 N. R. 2 E. W  
*6 1/2* miles *S* of *Wadsworth*  
 (distance) (direction) (nearest town)

WELL PURPOSE: *Domestic*  
 (home, irrigation, municipal, industrial)

WELL COMPLETION DATA:

(1) diameter (inches) 4 1/2

(2) total depth (feet) 100

(3) static water level (feet) \_\_\_\_\_ below/above top of ground.

(4) casing (material) \_\_\_\_\_ (depth) \_\_\_\_\_  
 (size) \_\_\_\_\_ If telescope see back.

(5) screen 10 ft  
 (length) (depth to top) \_\_\_\_\_  
 (size) \_\_\_\_\_ (material) \_\_\_\_\_

(6) pump 1/2 (HP) 10 (yield gpm)  
Elec  
 (type power)

(7) electric log no  
 (yes or no)

(organization running log) \_\_\_\_\_

(8) how well bottom plugged Piling

CODED


JAN 27 1969

MISS. Bd. of WATER COMMISSIONERS

DRILLERS REMARKS:  
*See Log*

If well telescopes please sketch and show depths.

GROUND LEVEL

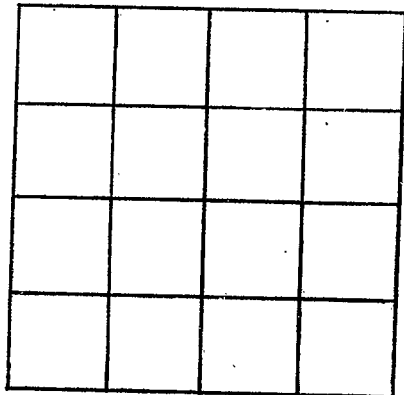

SECTION \_\_\_\_\_

Please indicate well location X.

ADDITIONAL INFORMATION

If more than one screen, show locations of each on sketch.