

MARSHALL

T 6

69

MISSISSIPPI BOARD OF WATER COMMISSIONERS
416 North State Street
Jackson, Mississippi 39201

WATER WELL DRILLERS LOG

Atkinson & Frost

Marshall

date well completed

firm name

county well located

LANDOWNER:

Fred Smith

description of formations encountered

from to

Waterford Miss
(mailing address)

Clay

0 60

sand

60 150

Clay

145 160

white sand

160 200

WELL LOCATION:

sec. 5 T. 6 N. R. 2 E. Waterford
4 miles NE of (nearest town)

WELL PURPOSE:

(home, irrigation, municipal, industrial)

WELL COMPLETION DATA:

- (1) diameter (inches) 4"
- (2) total depth (feet) 200
- (3) static water level (feet) 178 below top of ground.
- (4) casing P.V.C. 150 (material) (depth)
(size) If telescope see back.
- (5) screen 10 190 (length) (depth to top)
4" P.V.C. (size) (material)
- (6) pump 3/4 10 (HP) (yield gpm)
Elec (type power)
- (7) electric log (yes or no)

(organization running log)

(8) how well bottom plugged Cap


DRILLERS REMARKS:

SEP - 5 1960

MISS. BD. OF WATER COMM.

If well telescopes please sketch and show depths.

GROUND LEVEL

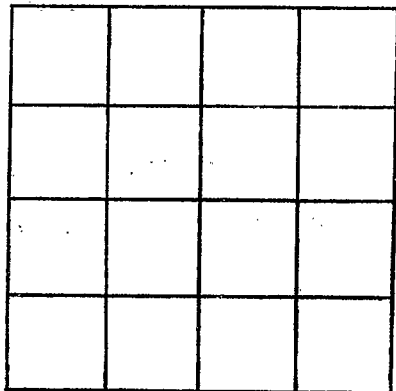

SECTION _____

Please indicate well location X.

ADDITIONAL INFORMATION

If more than one screen, show locations of each on sketch.