

CODED

MISSISSIPPI
BOARD OF WATER COMMISSIONERS
416 North State Street
Jackson, Mississippi 39201

WATER WELL DRILLERS LOG

Marshall
T 7
8-21-69

8-21-69 date well completed
Dempsey Well Co firm name
Marshall county well located

LANDOWNER: Lady Mears

description of formations encountered

from to

R#3
Holly Springs, Miss.
(mailing address)

Clay

0 20

WELL LOCATION:
sec. 6 T 5 N R 2 E
S W
4 miles South of Holly Springs
(distance) (direction) (nearest town)

Sand

20 120

clay

120 150

Sand

150 220

WELL PURPOSE:
(home, irrigation, municipal, industrial)

WELL COMPLETION DATA:

(1) diameter (inches) 4"

(2) total depth (feet) 220 feet

(3) static water level (feet) 160 below above top of ground.

(4) casing PVC 220 feet (material) (depth)

(size) if telescope see back.

(5) screen 6 ft. 2 1/4 ft (length) (depth to top)

4" Gravel Wash (size) (material)

(6) pump 3/4 10 (HP) (yield gpm)

(type power)

(7) electric log Elect. (yes or no)

(organization running log)

(8) how well bottom plugged 4" cap


DRILLERS REMARKS:

DEC -1 1969

MISS. REG. OF WATER CONTROL

If well telescopes please sketch and show depths.

GROUND LEVEL

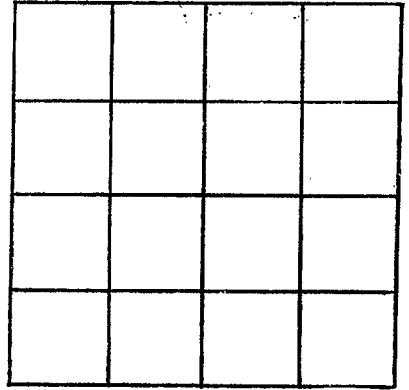

SECTION _____

Please indicate well location X.

ADDITIONAL INFORMATION

If more than one screen, show locations of each on sketch.