

Marshall
T 8

MISSISSIPPI
BOARD OF WATER COMMISSIONERS
416 North State Street
Jackson, Mississippi 39201

CODED

WATER WELL DRILLERS LOG

Atkinson & Frost Marshall

19
date well completed

firm name

county well located

LANDOWNER:
Robert Colver
Water Ford Miss
(mailing address)

description of formations encountered	from	to
<u>Red Clay</u>	<u>0</u>	<u>15</u>
<u>Red SAND</u>	<u>15</u>	<u>50</u>
<u>White SAND</u>	<u>50</u>	<u>135</u>

WELL LOCATION:
sec. 5 T 5 N R. 2 E
4 miles SE of Waterford
(distance) (direction) (nearest town)

WELL PURPOSE:
(home, irrigation, municipal, industrial)

- WELL COMPLETION DATA:
- (1) diameter (inches) 4"
 - (2) total depth (feet) 135
 - (3) static water level (feet) 90 below above ground.
 - (4) casing P.V.C., 135,
(material) (depth)
(size) If telescope see back.
 - (5) screen 10', 125
(length) (depth to top)
4", P.V.C.
(size) (material)
 - (6) pump 3/4, 12
(HP) (yield gpm)
Elec.
(type power)
 - (7) electric log
(yes or no)

(organization running log)

(8) how well bottom plugged CAP.

DRILLERS REMARKS:


CODED

MAR 17 1970

REC'D. BY
OFFICE OF
WATER COMMISSIONERS

If well telescopes please sketch and show depths.

GROUND LEVEL

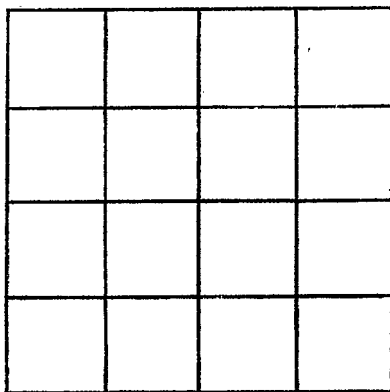

SECTION _____

Please indicate well location X.

ADDITIONAL INFORMATION

If more than one screen, show locations of each on sketch.