

CODED

MISSISSIPPI
BOARD OF WATER COMMISSIONERS
416 North State Street
Jackson, Mississippi 39201

MARSHALL
T 9
7-10-72

WATER WELL DRILLERS LOG

July 10 1972 date well completed
Hicks Brothers Well Co. firm name
Marshall county well located

LANDOWNER: Lennie Jeffries
Pt. 2
Potts Camp, Miss.
(mailing address)

description of formations encountered	from	to
Red sandy clay	0	30
White sand	30	45
White sandy clay	45	120
White sand	120	135

WELL LOCATION:
sec. 2 T 5 N R. 2 E
1 miles S/E of Holly Springs
(distance) (direction) (nearest town)

WELL PURPOSE: Home
(home, irrigation, municipal, industrial)


- WELL COMPLETION DATA:
- (1) diameter (inches) 4"
 - (2) total depth (feet) 135
 - (3) static water level (feet) 83 below above top of ground.
 - (4) casing Plastic ~~125~~
(material) (depth)
 - (size) if telescope see back.
 - (5) screen 10' 10'
(length) (depth to top)
 - 4" plastic slotted
(size) (material)
 - (6) pump 3/4 10
(HP) (yield gpm)
 - 220
(type power)
 - (7) electric log no
(yes or no)
 - (organization running log)
 - (8) how well bottom plugged cap

CODED

DRILLERS REMARKS: cap
JUL 17 1972
MISS. ED
WATER C.

If well telescopes please sketch and show depths.

GROUND LEVEL

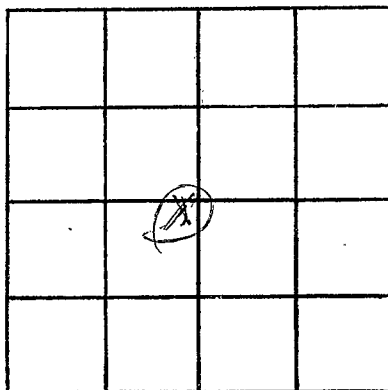

SECTION _____

Please indicate well location X.

ADDITIONAL INFORMATION

If more than one screen,
show locations of each on sketch.