

**MARSHALL**  
**T 12**  
**1-10-72**

MISSISSIPPI  
**BOARD OF WATER COMMISSIONERS**  
 416 North State Street  
 Jackson, Mississippi 39201

**FEB 16 1972**

**WATER WELL DRILLERS LOG**

MISS. BD. OF


1-10 1972 H. Dean & Co. Drilling firm name Marshall county well located

LANDOWNER:	description of formations encountered	from	to
<u>Coro Mc Intyre</u>			
<u>Holly Springs</u> (mailing address)	<u>Sand</u>	<u>20</u>	<u>160</u>
WELL LOCATION:	<u>Clay</u>	<u>160</u>	<u>170</u>
sec. <u>7</u> T <u>5</u> N R <u>3</u> E	<u>Sand</u>	<u>170</u>	<u>230</u>
<u>15</u> miles <u>South</u> of <u>Holly Springs</u>			
(distance) (direction) (nearest town)			
WELL PURPOSE: <u>Drilling</u> (home, irrigation, municipal, industrial)			
WELL COMPLETION DATA:			
(1) diameter (inches) <u>4</u>			
(2) total depth (feet) <u>230 feet</u>			
(3) static water level (feet) <u>185</u> below top of ground.			
(4) casing <u>PVC</u> , <u>230 feet</u> (material) (depth)			
(size) If telescope see back.			
(5) screen <u>6 ft.</u> , <u>22 1/2 feet</u> (length) (depth to top)			
<u>4"</u> , <u>gravel wall</u> (size) (material)			
(6) pump <u>3/4</u> , <u>10</u> (HP) (yield gpm)			
(type power)			
(7) electric log <u>Elect.</u> (yes or no)			
(organization running log)			
(8) how well bottom plugged <u>4" cap</u>			
DRILLERS REMARKS:			

**CODED**

If well telescopes please  
sketch and show depths.

GROUND LEVEL

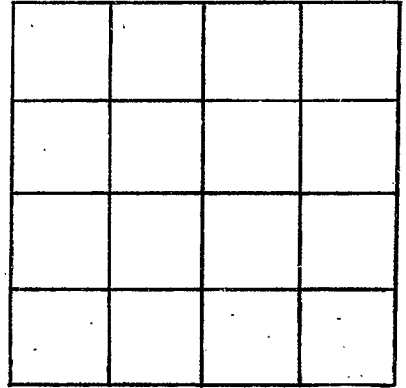

SECTION \_\_\_\_\_

Please indicate well location X.

ADDITIONAL INFORMATION

If more than one screen,  
show locations of each on sketch.