

MARSHALL
T 14
10-20-72

MISSISSIPPI
 BOARD OF WATER COMMISSIONERS
 416 North State Street
 Jackson, Mississippi 39201
WATER WELL DRILLERS LOG

CODED

10-20 1972 Hicks Brothers Marshall
 date well completed firm name county well located

LANDOWNER: <u>Johnnie Hubbard</u>	description of formations encountered	from	to
<u>Rt. 2 Box 86</u>	<u>Red sandy clay</u>	<u>0</u>	<u>35</u>
<u>POTS CAMP</u> (mailing address)	<u>White sand</u>	<u>35</u>	<u>135</u>

WELL LOCATION:
 sec. 2 T 5 N R 2 E
2 miles East of Lake Center
 (distance) (direction) (nearest town)

WELL PURPOSE: Home
 (home, irrigation, municipal, industrial)

CODED

- WELL COMPLETION DATA:
- (1) diameter (inches) 4"
 - (2) total depth (feet) 135
 - (3) static water level (feet) 85 below above top of ground.
 - (4) casing Plastic, 129
 (material) (depth)
 (size) if telescope see back.
 - (5) screen 6' x 18", 18"
 (length) (depth to top)
4", Cravel Plastic
 (size) (material)
 - (6) pump 3/4 10
 (HP) (yield gpm)
220 ETC
 (type power)
 - (7) electric log NO
 (yes or no)
 (organization running log)
 - (8) how well bottom plugged CAP


OCT 27 1972

DRILLERS REMARKS:

MISSISSIPPI
 BOARD OF WATER COMMISSIONERS
 JACKSON, MISSISSIPPI

If well telescopes please sketch and show depths.

GROUND LEVEL

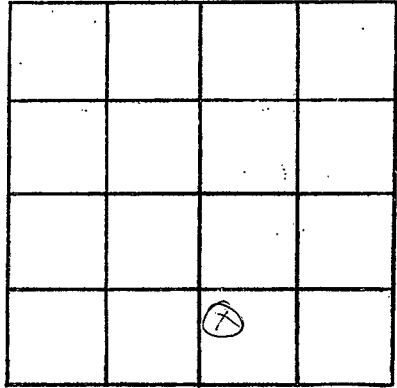

SECTION _____

Please indicate well location X.

ADDITIONAL INFORMATION

If more than one screen,
show locations of each on sketch.