

**MARSHALL**  
**T 15**  
**2-28-73**

MISSISSIPPI  
**BOARD OF WATER COMMISSIONERS**  
 416 North State Street  
 Jackson, Mississippi 39201

**WATER WELL DRILLERS LOG**

2-28 1973 Dean Kent Pumps well Marshall  
 date well completed firm name county well located

LANDOWNER:	description of formations encountered	from	to
<u>Freddie Hicks</u>		<u>Clay</u>	<u>0</u>
<u>RT of Holly Springs, Miss</u> (mailing address)	<u>Sand</u>	<u>30</u>	<u>100</u>
<b>WELL LOCATION:</b>	<u>Clay</u>	<u>100</u>	<u>102</u>
sec. <u>2</u> T. <u>5</u> N. R. <u>2</u> E.	<u>Sand</u>	<u>102</u>	<u>150</u>
<u>2</u> miles <u>West</u> of <u>Roberson</u> (distance) (direction) (nearest town)			
<b>WELL PURPOSE:</b> <u>Drillers</u> (home, irrigation, municipal, industrial)			
<b>WELL COMPLETION DATA:</b>			
(1) diameter (inches) <u>4"</u>			
(2) total depth (feet) <u>150 feet</u>			
(3) static water level (feet) <u>10'</u> below top of ground.			
(4) casing <u>P.V.C.</u> <u>150 feet</u> (material) (depth)			
(size) if telescope see back.			
(5) screen <u>8 feet</u> <u>142 feet</u> (length) (depth to top)			
<u>5"</u> <u>gravel wall</u> (size) (material)			
(6) pump <u>3/4</u> <u>17</u> (HP) (yield gpm)			
(type power)			
(7) electric log <u>Clay</u> (yes or no)			
(organization running log)			
(8) how well bottom plugged <u>4" cap</u>			
<b>DRILLERS REMARKS:</b>			

**CODED**


**CODED**

MISS. B. OF WATER COMM. 1973

MISS. BD. OF WATER COMM.

If well telescopes please sketch and show depths.

GROUND LEVEL

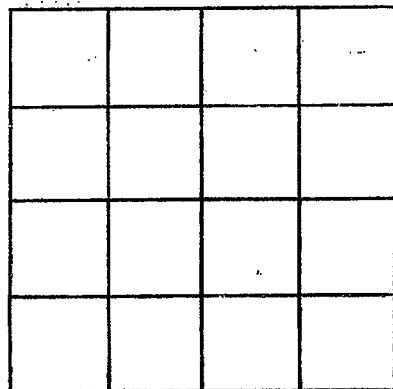

SECTION \_\_\_\_\_

Please indicate well location X.

ADDITIONAL INFORMATION

If more than one screen,  
show locations of each on sketch.