

MARSHALL

T 16

8-13-73

8-13-

date well completed

MISSISSIPPI
BOARD OF WATER COMMISSIONERS
416 North State Street
Jackson, Mississippi 39201

CODED
SLIP

MISS. BD. OF
WATER COMM.

WATER WELL DRILLERS LOG

19 B. B. B. Bros. Well

firm name

Marshall
county well located

LANDOWNER: Sam Smith

Smith - Rt 2 Box 161

Pot. Camp Miss
(mailing address)

description of formations encountered

from

to

<u>Red Sand</u>	<u>0</u>	<u>15</u>
<u>Red Sand + Clay</u>	<u>15</u>	<u>30</u>
<u>Black Clay</u>	<u>30</u>	<u>105</u>
<u>Black Clay + Sand</u>	<u>105</u>	<u>120</u>
<u>White Sand</u>	<u>120</u>	<u>200</u>

WELL LOCATION:

sec. 14 T. 5 N. R. 2 E.
3 miles E of Center
(distance) (direction) (nearest town)

CODED

WELL PURPOSE: Home
(home, irrigation, municipal, industrial)

WELL COMPLETION DATA:

(1) diameter (inches) 4 1/2 in.

(2) total depth (feet) 200

(3) static water level (feet) 150 below top of ground.

(4) casing Plastic 200
(material) (depth)

(size) if telescope see back.

(5) screen 5 ft, 195
(length) (depth to top)

4 in. Gravel
(size) (material)

(6) pump 3/4 10
(HP) (yield gpm)

Electric 220
(type power)

(7) electric log No
(yes or no)


(organization running log)

(8) how well bottom plugged Cap

DRILLERS REMARKS:

If well telescopes please
sketch and show depths.

GROUND LEVEL

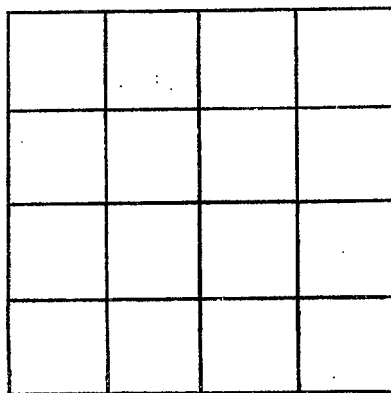

SECTION _____

Please indicate well location X.

ADDITIONAL INFORMATION

If more than one screen,
show locations of each on sketch.