

**MARSHALL**  
**T 17**  
**10-12-73**

MISSISSIPPI  
 BOARD OF WATER COMMISSIONERS  
 416 North State Street  
 Jackson, Mississippi 39201

**CODED**

**WATER WELL DRILLERS LOG**

10-12-73 date well completed  
 Dean Hart Bumpers firm name  
 Marshall county well located

LANDOWNER:	description of formations encountered	from	to
Best Bonds			
Neely Springs, Miss. (mailing address)	sand	20	75

**WELL LOCATION:**  
 sec. 14 T. 5 N. R. 2 E. W. 3  
 10 miles South of Neely Springs  
 (distance) (direction) (nearest town)

**WELL PURPOSE:** Drillers  
 (home, irrigation, municipal, industrial)

- WELL COMPLETION DATA:**
- (1) diameter (inches) 4"
  - (2) total depth (feet) 75
  - (3) static water level (feet) 50 below above top of ground.
  - (4) casing PVC 75 ft.  
 (material) (depth)  
 (size) if telescope see back.
  - (5) screen 2 ft. 67 ft.  
 (length) (depth to top)  
6" gravel  
 (size) (material)
  - (6) pump 1/2 10  
 (HP) (yield gpm)  
 (type power)
  - (7) electric log Elect.  
 (yes or no)  
 (organization running log)
  - (8) how well bottom plugged 4" cap.

**CODED**


DRILLERS REMARKS:

NOV 9 1973

MISS. DIV. OF WATER CONTROL

If well telescopes please sketch and show depths.

GROUND LEVEL

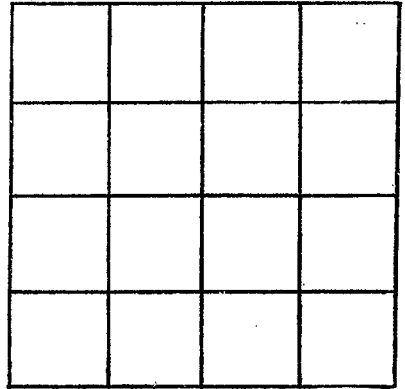

SECTION \_\_\_\_\_

Please indicate well location X.

ADDITIONAL INFORMATION

If more than one screen,  
show locations of each on sketch.