

**MARSHALL**  
**T 18**  
**9-24-73**

MISSISSIPPI  
 BOARD OF WATER COMMISSIONERS  
 416 North State Street  
 Jackson, Mississippi 39201 **CODED**

**WATER WELL DRILLERS LOG**

Sept. 24 1973 Robert W. Wilson Marshall  
 date well completed firm name county well located

LANDOWNER: John Herndon  
Whiterford, Miss  
 (mailing address)

description of formations encountered	from	to
red clay, red sand	0	31
red sand, yellow sand	31	60
yellow sand, white clay	60	90
white clay, white sand	90	105
white sand	105	120

WELL LOCATION:  
 sec. 19 T 5 N R 2 E  
 (distance) miles (direction) of (nearest town)

WELL PURPOSE:  
 (home, irrigation, municipal, industrial)

- WELL COMPLETION DATA:
- (1) diameter (inches) 4
  - (2) total depth (feet) 120
  - (3) static water level (feet) 80 below above top of ground.
  - (4) casing 4 (material), 116 (depth),  
 (size) if telescope see back.
  - (5) screen 4 (length), 116 (depth to top)  
4 (size), gravel packed (material)
  - (6) pump 3/4 (HP), 10 (yield gpm)  
electric (type power)
  - (7) electric log (yes or no) \_\_\_\_\_  
 (organization running log) \_\_\_\_\_
  - (8) how well bottom plugged 4"  
plastic cap

**CODED**




FEB 19 1974

MISSISSIPPI BOARD OF WATER COMMISSIONERS

DRILLERS REMARKS:

If well telescopes please sketch and show depths.

GROUND LEVEL

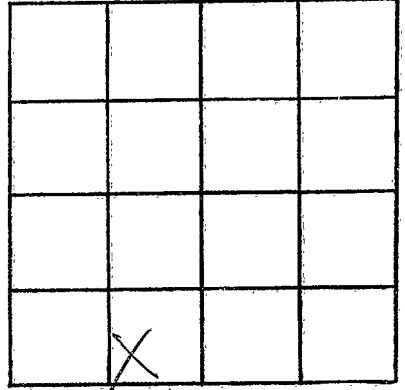

SECTION 19

Please indicate well location X.

ADDITIONAL INFORMATION

If more than one screen,  
show locations of each on sketch.