

MARSHALL
T21
9-15-75

MISSISSIPPI
BOARD OF WATER COMMISSIONERS
416 North State Street
Jackson, Mississippi 39201

CODED

WATER WELL DRILLERS LOG

9-15 1975 Dean & Kent Burf ^{Drillers} Marshall
date well completed firm name county well located

LANDOWNER:
Fred Walton Sr.
Waterford Miss.
(mailing address)

description of formations encountered	from	to
clay	0	20
sand	20	110
clay	110	128
sand	128	140

WELL LOCATION:
sec. 21 T. 5 N. R. 2 E.
5 miles East of Waterford
(distance) (direction) (nearest town)

WELL PURPOSE: drinking
(home, irrigation, municipal, industrial)

WELL COMPLETION DATA:

- (1) diameter (inches) 4"
- (2) total depth (feet) 140 feet
- (3) static water level (feet) 90 feet below top of ground.
- (4) casing pvc 140 feet
(material) (depth)
- (size) if telescope see back.
- (5) screen 7 ft. 133 feet
(length) (depth to top)
- 4" gravel wash
(size) (material)
- (6) pump 3/4 14
(HP) (yield gpm)
- (type power)
- (7) electric log elect.
(yes or no)
- (organization running log)
- (8) how well bottom plugged 4" cap.


DRILLERS REMARKS:

RECEIVED
OCT - 2 1975

MISSISSIPPI BOARD OF WATER COMMISSIONERS

If well telescopes please sketch and show depths.

GROUND LEVEL

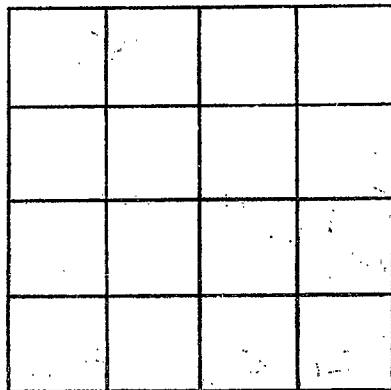

SECTION _____

Please indicate well location X.

ADDITIONAL INFORMATION

If more than one screen,
show locations of each on sketch.