

MISSISSIPPI DEPARTMENT OF ENVIRONMENTAL QUALITY

Office of Land and Water Resources

P. O. Box 10631
Jackson, MS 39289-0631
WATER WELL DRILLERS LOG

COUNTY WELL LOCATED
MARSHALL

WELL NUMBER
T-24

CODED

PERMIT NUMBER

NAME OF DRILLING FIRM
Medlin

DATE WELL COMPLETED
7-10-02

NAME & MAILING ADDRESS OF LANDOWNER
**Hemay Ash
1017 EVANS Rd.**

Latitude:
Longitude:

WELL LOCATION. SEC **25** TOWNSHIP **S 5** RANGE **2** **(S)** **(W)**

DISTANCE **4** MILES DIRECTION **S/W** NEAREST TOWN **Potts Camp**

OTHER LANDMARK
Lebanon Church

WELL PURPOSE (Home) Irrigation, Municipal, Industrial, Fish Pond, etc.

PUMP DATA

PUMP TYPE (Circle One):
 Submersible, Turbine, Jet, Flowing Well,
Other (Describe)

POWER TYPE (Circle One):
 Electric, Tractor, Diesel, Gasoline, Butane,
Other (Describe) **H/P 1/2**

DESCRIPTION OF FORMATIONS ENCOUNTERED	FROM	TO
Top Soil, Rock	0,	250
Clay mix		
Blue Clay	250,	450
Shell rock, Clay	450,	600
agnation (Sand)	600,	670

RECEIVED

DEC 09 2002

BY: OLWR

Top of Lap Pipe or Reduction in Casing

FEET IF TELESCOPED OR MORE THAN ONE SCREEN: USE BACK PAGE

WELL DATA

Well Depth 670	Casing Diameter (In.) 4	Casing Length (Ft.) 300
Type of Casing Pvc	Hole Depth 670	Depth to Static Water Level 60'

TYPE OF COMPLETION: (Circle One or More):
 Gravel Packed, Underreamed, Telescoped,
 Natural Development, Open Hole, Other
(Describe)

WELL GROUTED TO A DEPTH OF **12** FEET
Type Grout (circle one) Cement, Bentonite, or Mix

SCREEN DATA

Diameter - Inches 2	Length - Feet 60	Slot Size - Inches 0.13
Screen Type Pvc	Depth to Bottom - Feet 610, 670	

I certify that the well was drilled, constructed and completed in accordance with all applicable Requirements of the Mississippi Department of Environmental Quality and/or the Mississippi Department of Health regulations and state laws.


Jama R. Mc **0479**
Signature of Licensed Driller and License No.

7-12-02
Date

Additional Information Required On Back

If well telescopes please sketch and show depths.

GROUND LEVEL

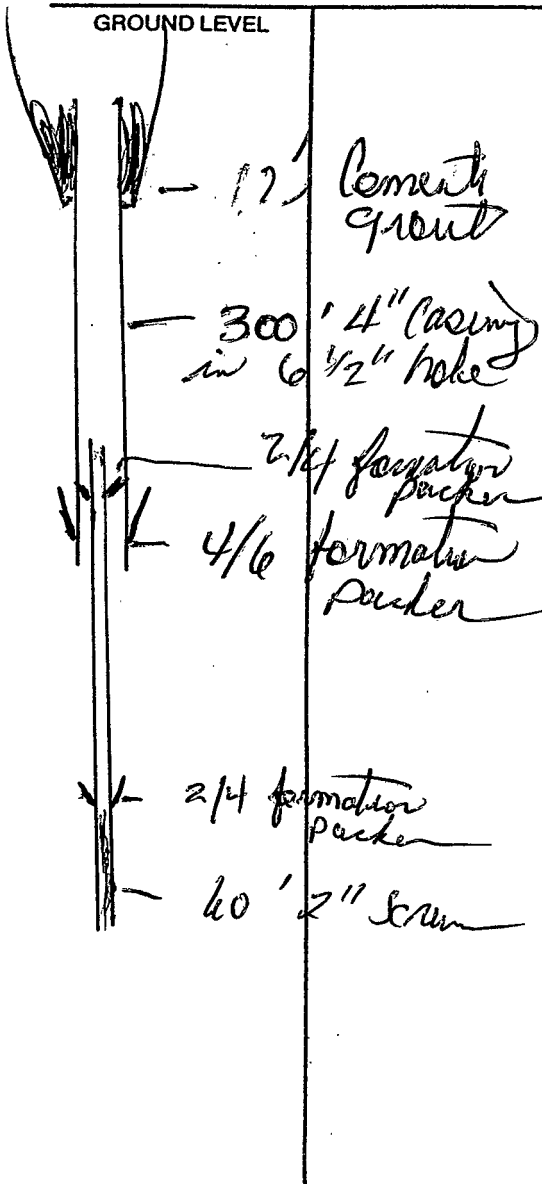

X			

SECTION 25

Please indicate well location X.

Pump Capacity (GPM)	No. of Stages	Setting Depth	
12	12	100	FT.
PUMP TEST			
Well yielded		12	GPM with
a drawdown of		3	ft.
after		8	hours of pumping

LOG DATA

TYPE OF LOG RUN (Circle One): No Log Run, Electric, Gamma Ray, Density, Sonic, Neutron, Other (Describe) _____

Name of Organization Running Log _____

GEOLOGIC DATA (Office Use Only)

Surface Elev.	Geologic Unit	Unit Thickness	Depth to Top
Subs. SWL	Date	Analysis	Aquifer Test

Driller's Remarks

If more than one screen, show location of each on sketch.