County: MArshall
Permit #:
Driller: Joses W. Mosow
Date drilling completed: 8-26-05

State Well Report

Part 1 - Driller's Log

Mississippi Department of Environmental Quality
Office of Land and Water Resources
P.O. Box 10631
Jackson, MS 39289-0631
(601)961-5210
(601)354-6938 (fax)

	For Office Use Only:
Aquife	r:
Well #	1-30
L. S. E	levation:
E-log ?	# :

State Law requires that this report be prepared by the license holder responsible for the work and filed with the Department at the above address within 30 days of completion of drilling of the well or borehole.

Information on Well Owner	Well or Borehole Location			
(Landowner if borehole is not for a water well)	Latitude: 34 º 41 ' 025" Langitude: 89 º 27 '392"			
Owner Name Moxine Smith	Latitude: $34 \circ 41 \circ 95$ Longitude: $89 \circ 7 \circ 35$			
	Method of Lat/Long (circle one): Conventional Survey,			
Mailing Address: 349 waterford mt rd	USGS quad, Hand-held GPS Survey-grade GPS			
	NW 1/4 NW 1/4 Sec 6 Twn 55 Rng DW			
Holly Spring Ms 38635 City State Zin Code				
City State Zip Code	Distance Direction Nearest Town			
Telephone No. (901) 229 - 8257	Distance Direction Nearest Town Order of water ford			
Telephone No. (No.) 484 - 883 /				
Well / Bore	hole Data			
Date drilling started: 8-3605 Date drilling completed: 8-36	OT Hele denth, 215' Hele diameter, 81'			
Date drilling started: Date drilling completed:	Hole depth: Hole diameter:			
Location of the source of any surface water used for drilling:	4			
Method of dosing and volume of Chlorine used in drilling and devel	opment: NA			
Logs run (circle all applicable): No log run Electric Gamma Ray	Dencity Sonic Neutron Others			
Name of organization running log(s):	Delisity Solic Neutron Other.			
Purpose of borehole (check one): Water Well Geotechnical/Geole	ogical Investigation Ground Source Heat Pump			
Seismic Survey Other (describe				
If drilling is not related to water well construction				
Purpose of Well (check one): Home Industrial Public Supply	Irrigation Fish Culture Other:			
If a flowing well, method of flow regulation: Valve A O	other (describe)			
Static Water Level: 145 feet above or below (circle one) land surface Date measured: 8-28-05				
Method of Measurement (circle one) steel tape electric tape	air line other Strong (2001)			
Well depth: 215 Well grouted to a depth of 10 feet Type				
Casing length: 195 feet Casing diameter: 4	inches Type of casing:			
Screen length:feet	inches Type of screen: $\rho \cup C$			
Screen slot size:ioloinches	195 feet to 215 feet			
Type of completion (circle all applicable): Gravel packed Under	reamed Telescoped Open hole Natural Development			
Other (describe):				
Top of lap pipe or reduction in casing: PA feet. If te				

RECEIVED

SEP 2 © 2005 BY: OLWR SEP 2 2005 BY: OLWR

Form: OLWR-SWR-1A

The sketch below only requ	uired for water wells
----------------------------	-----------------------


ľ	f well	telesco	pes,	show	depths	on	sketch.	
_			-					

f well	l telesco	pes, sho	w depti	is on s	ketch.
Gr	ound L	evel	K		

Description of formations encountered must be provided for all wells and boreholes, unless specifically exempted by regulations

Description of Formations Encountered	From (depth)	To (depth)
clay dirt.	Ground Level	18
write soud	81	215
		1

If more than one screen, show location of each on sketch

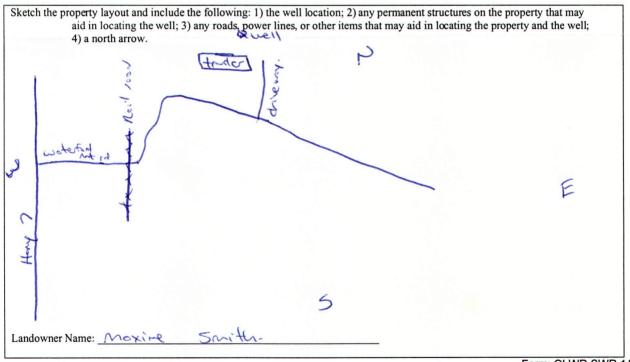

Form: OLWR-SWR-1A

I certify that the well/borehole was drilled, constructed, and completed in accordance with all applicable requirements of the Mississippi Department of Environmental Quality and the Mississippi Department of Health regulations, if applicable, and state

Print Name of Responsible Licensee and License No.

SEP 26 2005

BY: OLWR

STATE WELL REPORT Part 2 County: Marshall For Office Use Only: Pump Installer's Completion Report Mississippi Department of Environmental Quality Aquifer: Permit #: Office of Land and Water Resources Driller: Joses as Moses P.O. Box 10631 Jackson, MS 39289-0631 Date completed: 2-78-65 (601)961-5210 Elevation: (601)354-6938 (fax) Copy information from block on Part 1 This part of the report must be completed by a licensed water well contractor or a licensed pump installer. A copy of Part 1 of the report must be attached and both parts filed with the Department at the above address within 30 days of well completion. Well Location **Well Owner Information** Latitude: 34.41. 075 Longitude: 89.27.39 Owner Name: Moxime Smith. Method of Lat/Long (check one): Conventional Survey____, USGS quad , Hand-held GPS _____, Survey-grade GPS_____ NOW 1/2 NOW 1/2 Sec 6 T 55 R DW Nearest Town Direction Distance 3/12 Miles N or water ford Telephone No. (ctci) 329 - 8257 Power Type **Pump Type** Circle one Circle one Gasoline Engine Natural Gas Submersible Diesel Engine Air Lift Jet Tractor PTO Electric Motor Hand Turbine Bucket Piston Windmill Other (specify): Flowing Well Rotary Centrifugal Horse Power Rating of Motor: Other (specify): Date Pump Installed: 8- 38-05 Setting Depth: ____ Rated Pump Capacity: ____ Gallons Per Minute Number of Stages: ____ Method of Measuring Water Level Pump Test Data Circle one Date Well Tested: _____8- 38-05 Electric Measuring Line Steel Tape Air Line Static Water Level (A): 145 Feet Below Land Surface Other (specify): 5tring / weight Pumping Water Level (B): Feet Below Land Surface For flowing well, measured shut in head: _________ Drawdown [(B) - (A)]: Feet Below Land Surface Test Pumping Rate: ___ | 3 Well yielded GPM with a drawdown of Gallons Per Minute hours of pumping feet after Duration of Pump Test (minimum 4 hours): __________ hours

I HEREBY CERTIFY that the above statements are true to the best of my knowledge.

Print Name of Pump Installer and License No. (if applicable)

Signature of Pump Installer

B. I Bern West Source & B. Commer