

STATE WELL REPORT

Part 1

Driller's Log

Mississippi Department of Environmental Quality
Office of Land and Water Resources
P.O. Box 2309
Jackson, MS 39225-2309
(601)961-5210
(601)360-0535 (fax)

For Office Use Only:

Well #: T 46
Aquifer: _____
E-Log #: _____

County: Marshall
Permit #: 0163
Driller: Larry Carpenter
Date drilling completed: 11-11-14

State Law requires that this report be prepared by the license holder responsible for the work and filed with the Department at the above address within 30 days of completion of drilling of the well or borehole.

| Well Owner Information (Landowner if borehole is not for a water well) | Well or Borehole Location |
|---|--|
| Owner Name: <u>Elizabeth Banber</u> | Latitude: <u>34° 36' 27" N</u> Longitude: <u>89° 27' 43" W</u> |
| Mailing Address: <u>100 Pitts Rd</u> | Method of Lat/Long (check one): Conventional Survey _____ USGS quad _____, Hand-held GPS <input checked="" type="checkbox"/> , Survey-grade GPS _____ |
| <u>Waterford</u> MS <u>38685</u> | NE $\frac{1}{4}$ SE $\frac{1}{4}$, Sec <u>31E</u> T <u>5S</u> R <u>3W</u> |
| City State Zip Code | <u>2 1/2</u> Miles <u>S</u> of <u>Waterford</u> |
| Telephone No. <u>(843) 693-4500</u> | (Distance) (Direction) (Nearest Town) |

Well / Borehole Data

Date drilling started: 11-11-14 Date drilling completed: 11-11-14 Hole depth: 125 Hole diameter: 8"

Location of the source of any surface water used for drilling: Well Water

Method of dosing and volume of Chlorine used in drilling and development: 1/2 lb. Chlorine to 1000 Gal. water

Logs run (circle all applicable): No log run Electric Gamma Ray Density Sonic Neutron Other: _____

Name of organization running log(s): _____

Purpose of borehole (circle one): Water Well Geotechnical/Geological Investigation Ground Source Heat Pump
 Seismic Survey Other (describe) _____

If drilling is not related to water well construction, skip the remainder of this block

Purpose of Well (circle all applicable): Home Industrial Public Supply Irrigation Fish Culture

Other (describe): _____

If a flowing well, method of flow regulation: Valve _____ Other (describe) _____

Static Water Level: 86 feet [above or below] land surface Date measured: 11-11-14
(circle one)

Method of measurement (circle one): Steel tape Electric tape Air line Other (describe): _____

Well depth: 125 Well grouted to a depth of: 10 feet Type of grout (circle one): Neat Cement Bentonite Mix

Casing length: 115 feet Casing diameter: 4 inches Type of casing: PVC

Screen length: 10 feet Screen diameter: 4 inches Type of screen: PVC

Screen slot size: .013 inches Setting depth: From 115 feet to 125 feet

Type of completion (circle all applicable): Gravel packed Underreamed Open hole Natural Development

Other (describe): _____

Top of lap pipe or reduction in casing: _____ feet

If telescoped or more than one screen, describe on next page

RECEIVED

DEC 10 2014


Form: OLWR-SWR-1A (4/13)

BY OLWR

County: marshall
 Permit #: 0162

For Office Use Only:
 Well #: T46

*The sketch below only required for water wells
 If well telescopes, show depths on sketch.*

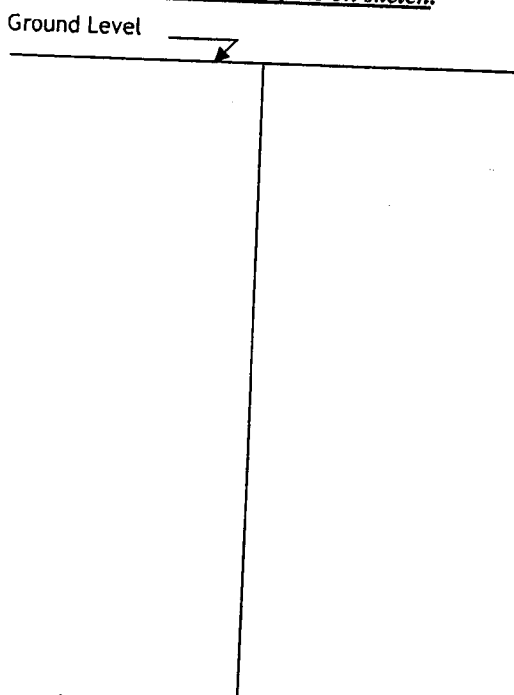


*Description of formations encountered must be provided for all wells
 and boreholes, unless specifically exempted by regulations*

| Description of Formations Encountered | From (depth) Ground level | To (depth) |
|---------------------------------------|------------------------------|------------|
| Surface Soil | | |
| Surface Soil | 0 | 18 |
| Med. Red Sand | 18 | 35 |
| Med. White Sand | 35 | 60 |
| White Clay | 60 | 72 |
| Med. White Sand | 72 | 90 |
| White Coarse Sand | 90 | 125 |
| | | |
| | | |
If more than one screen, show location of each on sketch

Sketch the property layout and include the following:

- 1) the well location
- 2) any permanent structures on the property that may aid in locating the well
- 3) any roads, power lines, or other items that may aid in locating the property and the well
- 4) north arrow

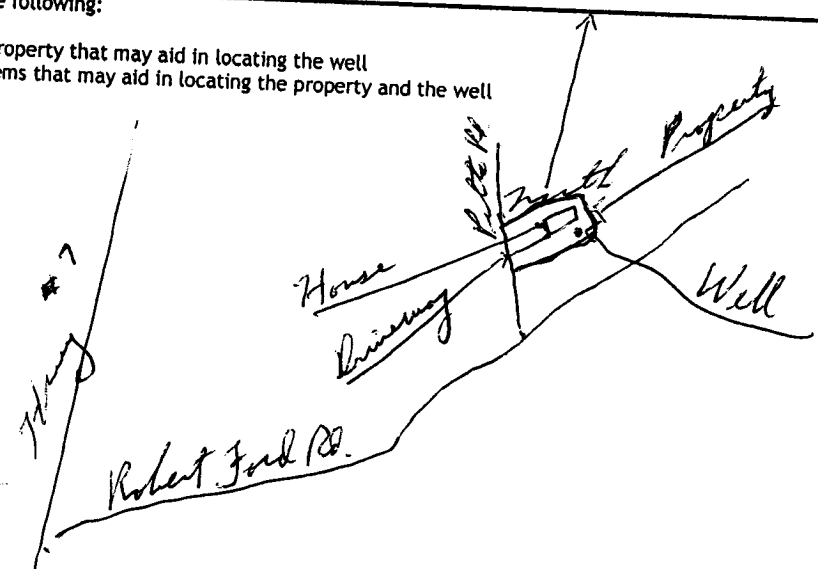

Landowner Name: Elizabeth Barber

I HEREBY CERTIFY that the well/borehole was drilled, constructed, and completed in accordance with all applicable requirements of the Mississippi Department of Environmental Quality and the Mississippi Department of Health regulations if applicable, and state laws.

Larry Carpenter #0162 11-12-14 Larry Carpenter
 Print Name of Responsible Licensee and License No. Date Signature of Licensee

Form: OLWR-SWR-1A (4/13)

RECEIVED
 DEC 10 2014
 BY CLAR

STATE WELL REPORT

Part 2

Pump Installer's Completion Report
Mississippi Department of Environmental Quality
Office of Land and Water Resources
P.O. Box 2309
Jackson, MS 39225-2309
(601)961-5210
(601) 360-0535 (fax)

For Office Use Only:

Well #: T46

Aquifer: _____

County: Marshall
Permit #: 162
Driller: Barry Carpenter
Date completed: 11-11-14
Copy information from block on Part 1

This part of the report must be completed by a licensed water well contractor or a licensed pump installer. A copy of Part 1 of the report must be attached and both parts filed with the Department at the above address within 30 days of well completion.

| Well Owner Information | | | Well Location | | | |
|--|-------------------------|--------------|---|---|------------------------|------------------|
| Owner Name: | <u>Elizabeth Barber</u> | | Latitude: | <u>34°36.276</u> | Longitude: | <u>89°27.437</u> |
| Mailing Address: | <u>100 Pitts Rd</u> | | Method of Lat/Long (check one): | Conventional Survey _____ | | |
| City: | State: | Zip Code: | USGS quad _____, | Hand-held GPS <input checked="" type="checkbox"/> | Survey-grade GPS _____ | |
| <u>Waterford</u> | <u>MS</u> | <u>38685</u> | <u>1/4</u> _____ <u>1/4</u> , Sec <u>31</u> T <u>5S</u> R <u>2W</u> | | | |
| Telephone No. (<u>843</u>) <u>693-4500</u> | | | <u>2 1/2</u> Miles <u>S</u> of <u>Waterford</u> | | | |
| | | | (Distance) | (Direction) | (Nearest Town) | |

Pump Type (circle one)
 Submersible Turbine Air Lift Centrifugal Flowing Well Jet Piston Rotary Other (describe): _____
Date Pump Installed: 11-11-14 Rated Pump Capacity: 10 Gallons Per Minute
Is This Pump (circle one): New Repaired Replacement

Power Type (circle one)
 Electric Diesel Gasoline Natural Gas Tractor PTO Windmill Other (describe): _____
Horse Power Rating of Motor: 3/4 Setting Depth: 100 feet Number of Stages: 11

Pump Test Data for Non Flowing Well
Date Well Tested: 11-11-14 Duration of Pump Test (minimum 4 hours): 4 hours
Static Water Level (A): 80 Feet Below Land Surface Pumping Water Level (B): 85 Feet Below Land Surface
Drawdown [(B) - (A)]: 5 Feet Below Land Surface Test Pumping Rate: 15 Gallons Per Minute
Method of measurement (circle one) Steel tape Electric tape Air line Other (describe): _____

Pump Test Data for Flowing Well
Measured shut in head: _____ feet.
Well yielded _____ GPM with a drawdown of _____ feet after _____ hours of pumping

Meter Installation
Meter Manufacturer: _____ Meter Serial Number: _____
Meter Model Number/Name: _____ Type of Meter: _____
Totalizer Register Unit and Multiplier Factor (AF x .001, gal x 1000, etc): _____
Installation Date: _____ Meter installed by: _____
Is This Meter (circle one): New Repaired Replacement
Important: By submitting the above information you are certifying that this meter was installed to manufacturer standards. For agricultural wells, a list of approved meters is on the MDEQ website.

I HEREBY CERTIFY that the above statements are true to the best of my knowledge.
Barry Carpenter # 0162 11-12-14 Barry Carpenter
Print Name of Pump Installer and License No. (if applicable) Date Signature of Pump Installer

RECEIVED
DEC 10 2014
BY: OLWR