

**MARSHALL**  
 T 2000  
 9-7-75

MISSISSIPPI  
 BOARD OF WATER COMMISSIONERS  
 416 North State Street  
 Jackson, Mississippi 39201

WATER WELL DRILLERS LOG

Sept 7 1975 R. L. Carpenter Marshall  
 date well completed firm name county well located

LANDOWNER: Mrs. Cora Mason  
 Holly Springs  
 Miss. RFD  
 (mailing address)


WELL LOCATION:  
 sec 35 T 5 N R 2 E  
 3 miles Northwest of Pella Corp  
 (distance) (direction) (nearest town)

WELL PURPOSE: Home  
 (home, irrigation, municipal, industrial)

- WELL COMPLETION DATA:
- (1) diameter (inches) 4
  - (2) total depth (feet) 127
  - (3) static water level (feet) 85 below top of ground.
  - (4) casing Plastic, 117 ft. (material) (depth)
  - (size) If telescope see back.
  - (5) screen 10 ft, 17 ft (length) (depth to top)  
 1/2" Plastic (size) (material)
  - (6) pump 1/2 (HP) 8 (yield gpm)  
 Elec. (type power)
  - (7) electric log No (yes or no)
  - (organization running log)
  - (8) how well bottom plugged Plastic Cap

description of formations encountered	from	to
Surface Soil	0	17
Coarse Red Sand	17	35
Fine White Sand	35	80
White Clay	80	87
White Coarse Sand	87	127

DRILLERS REMARKS:

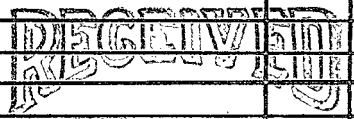

MAR 2 1975

If well telescopes please sketch and show depths.

GROUND LEVEL

		x	

SECTION 35

Please indicate well location X.

ADDITIONAL INFORMATION

If more than one screen, show locations of each on sketch.