

MARSHALL

T 2002

8-4-76

MISSISSIPPI BOARD OF WATER COMMISSIONERS 416 North State Street Jackson, Mississippi 39201

WATER WELL DRILLERS LOG

Aug. 4 1976 date well completed

R. L. Carpenter firm name

Marshall county well located

LANDOWNER: Marshall County Waterford Community Center Waterford, Miss. (mailing address)

Table with 3 columns: description of formations encountered, from, to. Rows include: Surface Soil (0-15), bed. Brown sand (15-36), malodorous white sand (36-69), white clay (69-94), white coarse sand (94-130)

WELL LOCATION:

sec. 18 T. 5 N. R. 2 E. In Waterford, Miss. (distance) miles (direction) of (nearest town)

WELL PURPOSE: Community Center (home, irrigation, municipal, industrial)

WELL COMPLETION DATA:

- (1) diameter (inches) 11
(2) total depth (feet) 130
(3) static water level (feet) 68 below above top of ground.
(4) casing Plastic 124' (material) (depth)
(5) screen 6' 124' (length) (depth to top) 4" Plastic & gravel (size) (material)
(6) pump 3/4 10 (HP) (yield gpm) Elec. (type power)
(7) electric log No (yes or no)

(8) how well bottom plugged Plastic cap


DRILLERS REMARKS:

RECEIVED MAY 12 1978

MISS. BD. OF WATER COMM

If well telescopes please sketch and show depths.

GROUND LEVEL

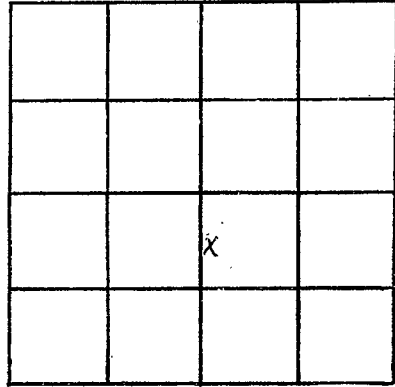

SECTION 18

Please indicate well location X.

ADDITIONAL INFORMATION

If more than one screen,
show locations of each on sketch.