

MARSHALL
T 2003
3-21-77

MISSISSIPPI
 BOARD OF WATER COMMISSIONERS
 416 North State Street
 Jackson, Mississippi 39201

15F

WATER WELL DRILLERS LOG

3-21-1977 Hick Well Co Marshall
 date well completed firm name county well located


LANDOWNER: <u>Mae Freeman</u>	description of formations encountered	from	to
<u>Holly Springs, Ms.</u> (mailing address)	<u>Red Clay</u>	0	40
WELL LOCATION:	<u>Red Sand</u>	40	80
sec. <u>1</u> T <u>5</u> N R <u>2</u> E <u>3/4</u> miles <u>S</u> of <u>Lake Center</u> (distance) (direction) (nearest town)	<u>White Sand</u>	80	120
WELL PURPOSE: <u>Home</u> (home, irrigation, municipal, industrial)	<u>Black Clay</u>	120	155
WELL COMPLETION DATA:			
(1) diameter (inches) <u>4</u>			
(2) total depth (feet) <u>155</u>			
(3) static water level (feet) <u>90</u> below top of ground.			
(4) casing <u>PVC</u> , <u>155</u> , (material) (depth)			
(size) If telescope see back.			
(5) screen <u>20 ft</u> , <u>85</u> (length) (depth to top)			
<u>4"</u> , <u>PVC & gravel</u> (size) (material)			
(6) pump <u>1/2</u> <u>10</u> (HP) (yield gpm)			
<u>220V</u> (type power)			
(7) electric log <u>No</u> (yes or no)			
(organization running log)			
(8) how well bottom plugged <u>gravel</u> <u>and sand</u>			
DRILLERS REMARKS:			

RECEIVED
 APR 8 1977

MISS. BD. OF WATER COMMISSIONERS

If well telescopes please sketch and show depths.

GROUND LEVEL

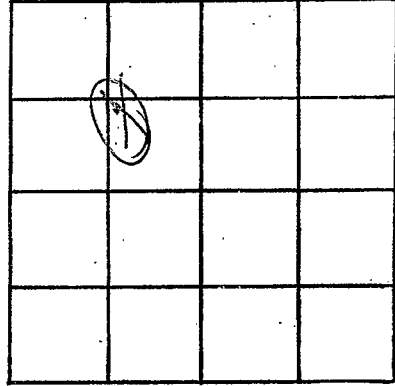

SECTION 1

Please indicate well location X.

ADDITIONAL INFORMATION

If more than one screen, show locations of each on sketch.