

MARSHALL  
T  
6-15-78  
2004

MISSISSIPPI  
BOARD OF WATER COMMISSIONERS  
416 North State Street  
Jackson, Mississippi 39201

WATER WELL DRILLERS LOG

6-15-1978 78 Keith Well Co Marshall  
date well completed firm name county well located

LANDOWNER	description of formations encountered	from	to
<u>Over Head Door Co</u>	Red Clay	0	10
<u>1/2 Davis</u>	Red Clay + Sand	10	60
<u>Memphis, Tenn</u> (mailing address)	Red Sand	60	90
WELL LOCATION:	Black Clay	90	230
sec <u>7</u> T <u>5</u> N R <u>2</u> E (S) (W)	white sand	230	287
<u>(342)</u> miles <u>E</u> of <u>Waterford</u> (distance) (direction) (nearest town)			
WELL PURPOSE: <u>Home</u> (home, irrigation, municipal, industrial)			
WELL COMPLETION DATA:			
(1) diameter (inches) <u>4</u>			
(2) total depth (feet) <u>287</u>			
(3) static water level (feet) <u>180</u> below top of ground.			
(4) casing <u>PVC</u> <u>287</u> (material) (depth)			
_____ if telescope see back. (size)			
(5) screen <u>17</u> <u>280</u> (length) (depth to top)			
<u>4"</u> <u>crushed type</u> (size) (material)			
(6) pump <u>3/4</u> <u>10</u> (HP) (yield gpm)			
<u>2200</u> (type power)			
(7) electric log <u>No</u> (yes or no)			
_____ (organization running log)			
(8) how well bottom plugged <u>Cap</u>			
DRILLERS REMARKS:			


RECEIVED

JUN 29 1978

MISSISSIPPI WATER COMMISSION

If well telescopes please sketch and show depths.

GROUND LEVEL

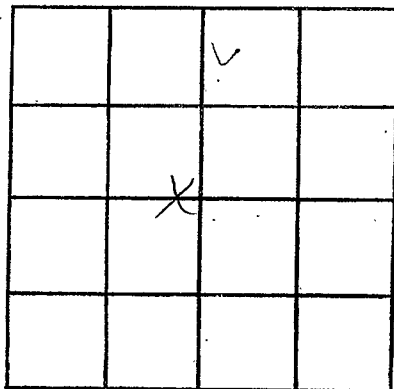

SECTION 7

Please indicate well location X.

ADDITIONAL INFORMATION

If more than one screen,  
show locations of each on sketch.