

MARSHALL
T
2005

MISSISSIPPI
BOARD OF WATER COMMISSIONERS
416 North State Street
Jackson, Mississippi 39201

WATER WELL DRILLERS LOG

7-26-1978 date well completed
Hickwell Co firm name
Marshall county well located

LANDOWNER: Douglas Smith
Rt. 5, Box 95
Holley Springs, Ms.
(mailing address)

description of formations encountered	from	to
	Red Clay	0
Red Sand	10	160

WELL LOCATION:
sec. 7 T. 3 N. R. 2 E. S. 1 W.
1 1/2 miles (distance) E (direction) of Waterford (nearest town)

White Sand	160	190
------------	-----	-----

WELL PURPOSE: Home
(home, irrigation, municipal, industrial)

WELL COMPLETION DATA:

- (1) diameter (inches) 4
- (2) total depth (feet) 190
- (3) static water level (feet) 160 below above top of ground.
- (4) casing PVC, 190
(material) (depth)

 if telescope see back.
(size)

- (5) screen 7', 183
(length) (depth to top)
4, gravel type
(size) (material)
- (6) pump 3/4, 18
(HP) (yield gpm)


220V
(type power)

- (7) electric log No
(yes or no)

(organization running log)

- (8) how well bottom plugged Cap


DRILLERS REMARKS:

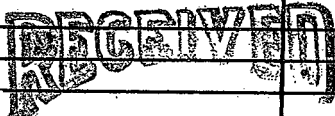

AUG - 7 1978

If well telescopes please sketch and show depths.

GROUND LEVEL

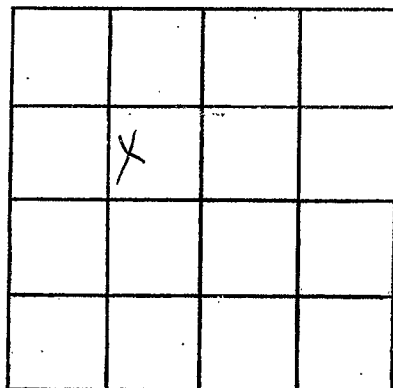

SECTION 2

Please indicate well location X.

ADDITIONAL INFORMATION

If more than one screen,
show locations of each on sketch.