

Marshall  
T 2007  
12/2/80  
12.2 1980

MISSISSIPPI  
 BOARD OF WATER COMMISSIONERS  
 416 North State Street  
 Jackson, Mississippi 39201

WATER WELL DRILLERS LOG

date well completed 12.2 1980 firm name Grant Well Supply county well located Marshall

LANDOWNER:

H. L. Russon

description of formations encountered

from

to

Waterford Miss.  
 (mailing address)

<u>Clay</u>	<u>0</u>	<u>25</u>
<u>Sand</u>	<u>25</u>	<u>80</u>
<u>Clay</u>	<u>80</u>	<u>88</u>
<u>Sand</u>	<u>88</u>	<u>140</u>

WELL LOCATION:

sec. 5 T. 5 N. R. 2 E  
2 miles E of Waterford  
 (distance) (direction) (nearest town)

WELL PURPOSE:

(home, irrigation, municipal, industrial)

WELL COMPLETION DATA:

- (1) diameter (inches) 4
- (2) total depth (feet) 140
- (3) static water level (feet) 100 below top of ground.

- (4) casing PVC 130  
 (material) (depth)

         If telescope see back.  
 (size)

- (5) screen 10 120  
 (length) (depth to top)

6'  
 (size) (material)

- (6) pump 3/4 12  
 (HP) (yield gpm)

elec.  
 (type power)

- (7) electric log no  
 (yes or no)

          
 (organization running log)

- (8) how well bottom plugged Cys

DEPT. OF NATURAL RESOURCES  
 BUREAU OF LAND & WATER RESOURCES


MAR -6 1981

RECEIVED

DRILLERS REMARKS:

If well telescopes please sketch and show depths.

GROUND LEVEL

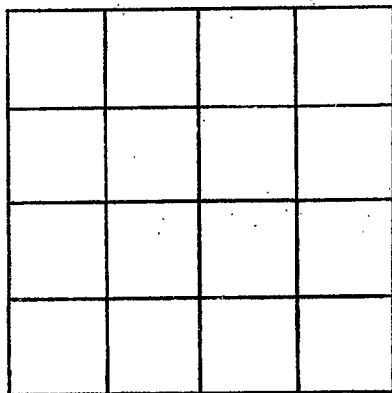

SECTION \_\_\_\_\_

Please indicate well location X.

ADDITIONAL INFORMATION

If more than one screen, show locations of each on sketch.