

MISSISSIPPI DEPARTMENT OF NATURAL RESOURCES
Bureau of Land and Water Resources
 Southport Mall
 P.O. Box 10631
 Jackson, Mississippi 39209
WATER WELL DRILLERS LOG

Marshall
T
2009

6-4 1983 Gullett Well Drilling Marshall
 date well completed firm name county well located

LANDOWNER: Fred Smith

description of formations encountered

from

to

Sand

0

120

Waterford, Ms.
 (mailing address)

WELL LOCATION:

sec. 18 T-5 N R-2 E
 (S) W
 miles 1.5 off Waterford
 (distance) (direction) (nearest town)

WELL PURPOSE: Home
 (home, irrigation, municipal, industrial)

WELL COMPLETION DATA:

- (1) diameter (inches) 4"
- (2) total depth (feet) 120'
- (3) static water level (feet) 120' below top of ground.
- (4) casing 160 PVC, 110'
 (material) (depth)
4" if telescope see back.
 (size)
- (5) screen 10', 110'
 (length) (depth to top)
4", 160 PVC
 (size) (material)
- (6) pump 3/4 10
 (HP) (yield gpm)
elec
 (type power)
- (7) electric log No
 (yes or no)
 (organization running log)
- (8) how well bottom plugged Cap

DEPT. OF NATURAL RESOURCES
 BUREAU OF LAND & WATER RESOURCES


JUN 21 1983

RECEIVED

DRILLERS REMARKS:

If well telescopes please sketch and show depths.

GROUND LEVEL

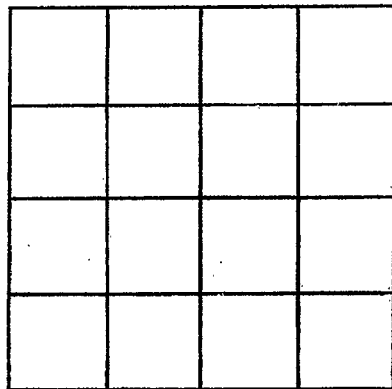

SECTION _____

Please indicate well location X.

ADDITIONAL INFORMATION

If more than one screen,
show locations of each on sketch.