

MISSISSIPPI DEPARTMENT OF NATURAL RESOURCES
Bureau of Land and Water Resources
 Southport Mall
 P.O. Box 10631
 Jackson, Mississippi 39209
WATER WELL DRILLERS LOG

Marshall
T 2010

2-6 1984 Wilson Well Co. Inc Marshall
 date well completed firm name county well located

LANDOWNER: Thomas Pitts
RT1 Box 197-B
Waterford, Ms
 (mailing address)

WELL LOCATION:
 sec. 3/T-5 N R 2 E
6 miles S of Waterford
 (distance) (direction) (nearest town)

description of formations encountered	from	to
<u>Brown CLAY</u>	<u>0</u>	<u>12</u>
<u>White Sand</u>	<u>12</u>	<u>36</u>
<u>White CLAY</u>	<u>36</u>	<u>39</u>
<u>White Sand</u>	<u>39</u>	<u>110</u>
<u>White CLAY</u>	<u>110</u>	<u>113</u>
<u>White Sand</u>	<u>113</u>	<u>153</u>

WELL PURPOSE: Home
 (home, irrigation, municipal, industrial)

WELL COMPLETION DATA:

(1) diameter (inches) 4

(2) total depth (feet) 153

(3) static water level (feet) 100 below above top of ground.

(4) casing PLASTIC 153
 (material) (depth)

4 If telescope see back.
 (size)

(5) screen 10 (length) (depth to top)
4 PLASTIC
 (size) (material)

(6) pump 3/4 9
 (HP) (yield gpm)

Elec.
 (type power)

(7) electric log No
 (yes or no)

(organization running log)

(8) how well bottom plugged 4" PVC CAP

DRILLERS REMARKS:


DEPT. OF NATURAL RESOURCES
 BUREAU OF LAND & WATER RESOURCES

MAR - 8 1984

RECEIVED

If well telescopes please sketch and show depths.

GROUND LEVEL

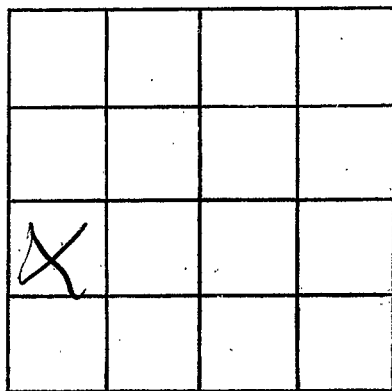

SECTION 31

Please indicate well location X.

ADDITIONAL INFORMATION

Lined area for additional information.

If more than one screen, show locations of each on sketch.