

MISSISSIPPI DEPARTMENT OF NATURAL RESOURCES

Bureau of Land and Water Resources

Southport Mall

P.O. Box 10631

Jackson, Mississippi 39209

WATER WELL DRILLERS LOG

HICKS WELL CO.

P.O. Box 157

Marshall  
T2011

9-4 1984  
date well completed

Hicks  
firm name

Marshall  
county well located

LANDOWNER: Randall Kank  
Box 224  
Waterford, Mo. 38685  
(mailing address)

description of formations encountered	from to	
Red Clay	0	10
Red Sand	10	30
White Sand + Clay	30	150
Black Clay	150	155
Rock	155	250
Black Clay	250	260
Rock	260	278
White Sand	278	

WELL LOCATION:  
sec. 22 T 5 N R 2 E  
4 miles E of Waterford  
(distance) (direction) (nearest town)

WELL PURPOSE: Home  
(home, irrigation, municipal, industrial)

WELL COMPLETION DATA:  
(1) diameter (inches) 4  
(2) total depth (feet) 278  
(3) static water level (feet) 220 <sup>below</sup>/<sub>above</sub> top of ground.  
(4) casing PVC, 278,  
(material) (depth)  
4"  
(size) if telescope see back.  
(5) screen 10', 268  
(length) (depth to top)  
1/2", PVC  
(size) (material)  
(6) pump 3/4, 10  
(HP) (yield gpm)  
220V  
(type power)  
(7) electric log No  
(yes or no)  
(organization running log)

(8) how well bottom plugged Cup

DRILLERS REMARKS:


DEPT. OF NATURAL RESOURCES  
BUREAU OF LAND & WATER RESOURCES

SEP 24 1984

RECEIVED

If well telescopes please sketch and show depths.

GROUND LEVEL

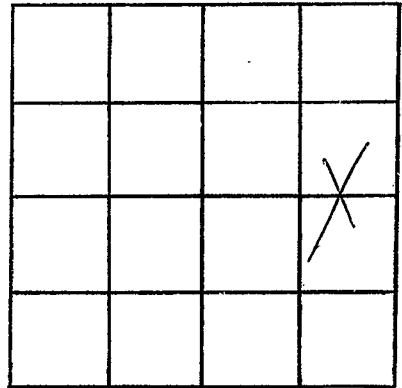

SECTION 22

Please indicate well location X.

ADDITIONAL INFORMATION

If more than one screen, show locations of each on sketch.