

MISSISSIPPI DEPARTMENT OF NATURAL RESOURCES

Bureau of Land and Water Resources

Southport Mall

P.O. Box 10631

Jackson, Mississippi 39209

WATER WELL DRILLERS LOG

Marshall
T2013

4-16
date well completed

1986 Derry Carpenter Well Co. Marshall
firm name

county well located

LANDOWNER: Ronnie Johnson

Waterford, Miss

R. F. D

(mailing address)

description of formations encountered

from

to

Surface Soil

0

12

Med. Red Sand

12

20

White Clay

20

45

Med White Sand

45

82

Fine White Sand & Clay

82

120

WELL LOCATION:

sec. 22 S N 2 E R 4 W
miles East of Waterford
(distance) (direction) (nearest town)

WELL PURPOSE: Home
(home, irrigation, municipal, industrial)

WELL COMPLETION DATA:

(1) diameter (inches) 4

(2) total depth (feet) 150

(3) static water level (feet) 10 below above top of ground.

(4) casing PVC, 130'
(material) (depth)

(size) if telescope see back.

(5) screen 20', 130'
(length) (depth to top)

4", PVC
(size) (material)

(6) pump 1/2, 10
(HP) (yield gpm)

Electric
(type power)

(7) electric log no
(yes or no)

(organization running log)

(8) how well bottom plugged PVC Cap


DRILLERS REMARKS:

RECEIVED
MAY 23 1985

Department of Natural Resources
Bureau of Land & Water

If well telescopes please
sketch and show depths.

GROUND LEVEL

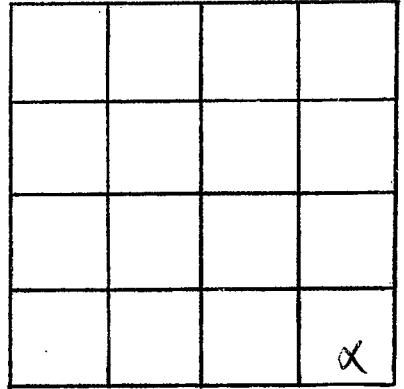

SECTION 4

Please indicate well location X.

ADDITIONAL INFORMATION

If more than one screen,
show locations of each on sketch.