

MISSISSIPPI DEPARTMENT OF NATURAL RESOURCES

Bureau of Land and Water Resources

COUNTY WELL LOCATED
Marshall

WELL NUMBER CODED
T 2014

DATE WELL COMPLETED
10-6-86

PERMIT NUMBER

NAME OF DRILLING FIRM
7 Wells Well Co.

P.O. Box 10631
Jackson, Mississippi 39209
WATER WELL DRILLERS LOG

NAME & MAILING ADDRESS OF LANDOWNER
*Jimie Wells
Waterford, MS*

WELL LOCATION: SEC TOWNSHIP RANGE
18 5 N 2 E W

DISTANCE DIRECTION NEAREST TOWN
1 Miles N of Waterford

OTHER LANDMARK

WELL PURPOSE Home Irrigation, Municipal, Industrial, Fish Pond, etc.

PUMP DATA

PUMP TYPE (Circle One):
 Submersible Turbine Jet Flowing Well,
Other (Describe) _____

POWER TYPE (Circle One):
 Electric Tractor Diesel Gasoline Butane,
Other (Describe) _____

Pump Capacity (GPM) No. of Stages Setting Depth
10 7 140 FT.

PUMP TEST

Well yielded *10* GPM with
a drawdown of _____ ft.
after _____ hours of pumping

WELL DATA

Well Depth <i>180'</i>	Casing Diameter (In.) <i>4"</i>	Casing Length (Ft.) <i>170'</i>
Type of Casing <i>PVC</i>	Hole Depth <i>180'</i>	Depth to Static Water Level <i>100'</i>

TYPE OF COMPLETION: (Circle One or More):
 Gravel Packed Underreamed Telescoped
Natural Development Open Hole Other
(Describe) _____

Top of Lap Pipe or Reduction in Casing
FEET IF TELESCOPED OR MORE THAN ONE SCREEN: USE BACK PAGE

LOG DATA

TYPE OF LOG RUN (Circle One): No Log Run, Electric, Gamma Ray, Density, Sonic, Neutron, Other (Describe) _____

Name of Organization Running Log

SCREEN DATA


Diameter - Inches <i>4"</i>	Length - Feet <i>10'</i>	Slot Size - Inches <i>.013</i>
Screen Type <i>PVC</i>	Depth to Bottom - Feet <i>10'</i>	

GEOLOGIC DATA (Office Use Only)

Surface Elev.	Geologic Unit	Unit Thickness	Depth to Top
Subs. SWL	Date	Analysis	Aquifer Test

Driller's Remarks


DESCRIPTION OF FORMATIONS ENCOUNTERED	FROM	TO	FORMATIONS (Continued)	FROM	TO
<i>red clay</i>	<i>0</i>	<i>10</i>			
<i>red sand</i>	<i>10</i>	<i>50</i>			
<i>white sand</i>	<i>50</i>	<i>180</i>			

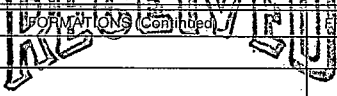
 OCT 29 1986
 Department of Natural Resources
 Bureau of Land & Water Resources

IF MORE SPACE IS NEEDED, USE BACK

If well telescopes please sketch and show depths.

GROUND LEVEL

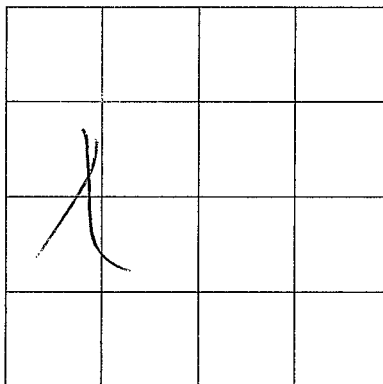

SECTION 1B

Please indicate well location X.

ADDITIONAL INFORMATION

If more than one screen,
show location of each on sketch.