

15F

CODED

CODED

MARshall  
 U5  
 10-1-68  
 Oct 1 68  
 date well completed

MISSISSIPPI  
 BOARD OF WATER COMMISSIONERS

416 North State Street

Jackson Mississippi 39201

Wilson Well Contr  
 WATER WELL DRILLERS LOG

19 Ma Miller  
 firm name

Marshall  
 county well located

LANDOWNER: Ma Miller  
 Halley Springs  
 (mailing address)

description of formations encountered	from	to
Black Clay	0	205
Black Sand	205	245

WELL LOCATION:  
 sec. 21 T. 5 N R. 7 E?  
 5 miles East of Waterford  
 (distance) (direction) (nearest town)

WELL PURPOSE: Home  
 (home, irrigation, municipal, industrial)

- WELL COMPLETION DATA:
- (1) diameter (inches) 4"
  - (2) total depth (feet) 245
  - (3) static water level (feet) 40 below top of ground
  - (4) casing Plastic 245 (material) (depth)
  - (size) if telescope see back.
  - (5) screen Non (length) (depth to top)
  - (size) (material)
  - (6) pump 3/4 10 (HP) (yield gpm)
  - Elect (type power)
  - (7) electric log (yes or no)
  - (organization running log)
  - (8) how well bottom plugged


CODED

JAN 29 1969  
 MISS. DIV. OF  
 WATER CONTROL

DRILLERS REMARKS:  
 B. Redmon

If well telescopes please sketch and show depths.

GROUND LEVEL

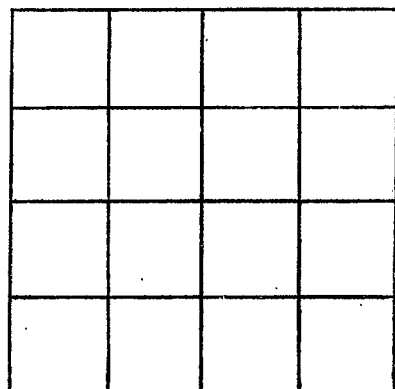

SECTION \_\_\_\_\_

Please indicate well location X.

ADDITIONAL INFORMATION

If more than one screen, show locations of each on sketch.