

MISSISSIPPI
BOARD OF WATER COMMISSIONERS
416 North State Street
Jackson, Mississippi 39201

CODED

FEB 19 1971

MISS. BD. OF
WATER COMM.

WATER WELL DRILLERS LOG

MARSHALL
U6
1-6-71

Jan 6 1971 date well completed
J. W. Webber firm name
Marshall county well located

LANDOWNER:
Jimmie Westmoreland
Potts Camp Miss
(mailing address)

| description of formations encountered | from | to |
|--|------|-----|
| Soil | 0 | 4 |
| Sand & Clay | 4 | 148 |
| Sand & Clay | 140 | 300 |
| Blue Rock | 300 | 700 |
| Water Rock | 700 | 710 |
| Water sand & Rock | 710 | 830 |
| Replg sand | | |
| 52.0 ft. 2" perf set in bottom of well | | |

WELL LOCATION:
sec. 9 T 53 N R 1 W E
S W
1 miles East of Potts Camp
(distance) (direction) (nearest town)

WELL PURPOSE:
(home, irrigation, municipal, industrial)


- WELL COMPLETION DATA:
- (1) diameter (inches) 5
 - (2) total depth (feet) 830
 - (3) static water level (feet) 90 below above top of ground.
 - (4) casing Steel 314ft
(material) (depth)
5 if telescope see back.
(size)
 - (5) screen 0 0
(length) (depth to top)
0 0
(size) (material)
 - (6) pump 1 1/2 HP Sub 25 gal
(HP) (yield gpm)
Elec
(type power)
 - (7) electric log 0
(yes or no)
0
(organization running log)
 - (8) how well bottom plugged Open

CODED

DRILLERS REMARKS:

If well telescopes please sketch and show depths.

GROUND LEVEL

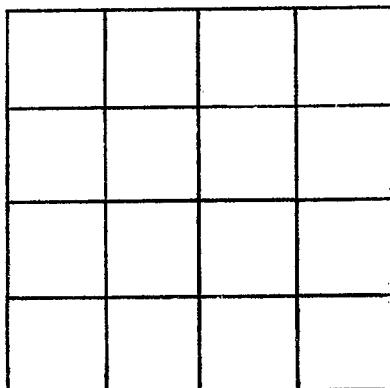

SECTION _____

Please indicate well location X.

ADDITIONAL INFORMATION

If more than one screen, show locations of each on sketch.