

MARSHALL

U 12

9-5-72

MISSISSIPPI  
 BOARD OF WATER COMMISSIONERS  
 416 North State Street  
 Jackson, Mississippi 39201

800.00  
 4509  
 845.00

WATER WELL DRILLERS LOG

**CODED**

9 5 1972  
date well completed

J T Medlin  
firm name

Marshall  
county well located

LANDOWNER:	description of formations encountered	from	to
Pete Riedell Pallscomp (mailing address)	Red Clay " sandstone Red	0 27	27 150
<b>WELL LOCATION:</b> sec. 21 T 5 N R 1 E 2 miles W of Bethelham (distance) (direction) (nearest town)			
<b>WELL PURPOSE:</b> (home, irrigation, municipal, industrial)			
<b>WELL COMPLETION DATA:</b>			
(1) diameter (inches) 4			
(2) total depth (feet) 150			
(3) static water level (feet) 20 below top of ground.			
(4) casing P 150. (material) (depth)			
(size) If telescope see back.			
(5) screen 10 140 (length) (depth to top)			
(size) (material)			
(6) pump 1/2 6 (HP) (yield gpm)			
E (type power)			
(7) electric log (yes or no)			
(organization running log)			
(8) how well bottom plugged			
<b>DRILLERS REMARKS:</b>			


**CODED**

OCT 12 1972

NO. OF  
WELLS

If well telescopes please sketch and show depths.

GROUND LEVEL

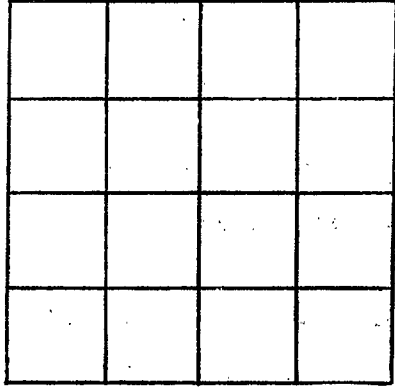

SECTION \_\_\_\_\_

Please indicate well location X.

ADDITIONAL INFORMATION

If more than one screen,  
show locations of each on sketch.