

**MARSHALL**  
U15  
**5-30-73**

MISSISSIPPI  
 BOARD OF WATER COMMISSIONERS  
 416 North State Street  
 Jackson, Mississippi 39201

940.00  
 37.00  
 -----  
 907.00

**CODED**

**WATER WELL DRILLERS LOG**

5 30 19 73 JT Walker Marshall  
 date well completed firm name county well located

LANDOWNER: John Walker  
 (mailing address)

description of formations encountered	from	to
<u>Sand</u>	<u>0</u>	<u>40</u>
<u>Clay sand</u>	<u>40</u>	<u>150</u>
<u>Sand</u>	<u>150</u>	<u>170</u>

WELL LOCATION:  
 sec. 6 T. 5 N. R. 1 E.  
3 miles NE of NEW PATTS  
 (distance) (direction) (nearest town)

WELL PURPOSE:  
 (home, irrigation, municipal, industrial)

WELL COMPLETION DATA:

(1) diameter (inches) 4

(2) total depth (feet) 170

(3) static water level (feet) 100 below top of ground.

(4) casing P 160  
 (material) (depth)

    if telescope see back.  
 (size)

(5) screen 10 160  
 (length) (depth to top)

4 P  
 (size) (material)

(6) pump 1/2 0  
 (HP) (yield gpm)

EM  
 (type power)

(7) electric log      
 (yes or no)

     
 (organization running log)

(8) how well bottom plugged Cape

**CODED**


**APR 10 1973**

DRILLERS REMARKS: \_\_\_\_\_

MISS. \_\_\_\_\_  
 W.P. \_\_\_\_\_

If well telescopes please sketch and show depths.

GROUND LEVEL

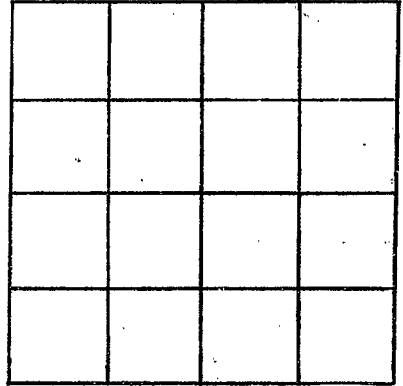

SECTION \_\_\_\_\_

Please indicate well location X.

ADDITIONAL INFORMATION

If more than one screen, show locations of each on sketch.