

MARSHALL

U 16

7-23-73

MISSISSIPPI BOARD OF WATER COMMISSIONERS 416 North State Street Jackson, Mississippi 39201

CODED

WATER WELL DRILLERS LOG

June 20 1973 date well completed

J. W. Webb & Son firm name Marshall county well located

LANDOWNER: W. M. Hawkins

Potts Camp Miss.

(mailing address)

description of formations encountered

from to

Soil	1	3
Clay & Sand	3	180
Red Sandstone	180	220
Blue Rock	220	330
Hard Rock	330	332
Blue Rock	332	800
Rocks & Sand	800	986
Ripley Sand		

WELL LOCATION:

sec. 18 T. 5 N. R. 1 W. E. 3 miles South of Potts Camp (distance) (direction) (nearest town)

WELL PURPOSE: (home, irrigation, municipal, industrial)

WELL COMPLETION DATA:

- (1) diameter (inches) 4"
- (2) total depth (feet) 986
- (3) static water level (feet) 139 below top of ground
- (4) casing Steel 4041 (material) (depth) 4" (size) if telescope see back.
- (5) screen 0 (length) 0 (depth to top) 0 (size) 0 (material)
- (6) pump Kyrusak 3 (HP) 3 (yield gpm) Elec (type power)
- (7) electric log (yes or no)
- (organization running log)
- (8) how well bottom plugged

CODED


DRILLERS REMARKS: purf pipe in bottom of well 600ft

JUL 16 1973

MISS. BO. WATER COM.

If well telescopes please sketch and show depths.

GROUND LEVEL

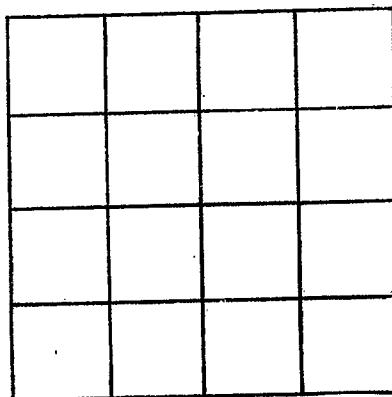

SECTION _____

Please indicate well location X.

ADDITIONAL INFORMATION

If more than one screen, show locations of each on sketch.