

MARSHALL
 U 18
 11-6-74

MISSISSIPPI
 BOARD OF WATER COMMISSIONERS
 416 North State Street
 Jackson, Mississippi 39201

CODED

WATER WELL DRILLERS LOG

11-6-1974 date well completed
 Dean Hart Buford Marshall firm name
 10 county well located

LANDOWNER:
 Mrs. H. A. Hart
 Rt 2, Potts Camp, Miss.
 (mailing address)

| description of formations encountered | from | to |
|---------------------------------------|------|---------|
| Clay | 0 | 10 |
| Sand | 10 | 70 feet |

WELL LOCATION:
 sec. 6 T 5 N R 1 E
 7 miles S.E. of Holly Springs
 (distance) (direction) (nearest town)

CODED

WELL PURPOSE: Drinking
 (home, irrigation, municipal, industrial)

WELL COMPLETION DATA:

(1) diameter (inches) 4"

(2) total depth (feet) 70 feet

(3) static water level (feet) 40 below above top of ground.

(4) casing PVC, 70 feet
 (material) (depth)

_____ if telescope see back.
 (size)

(5) screen 8 Ft., 62 feet
 (length) (depth to top)

4", Gravel Wall
 (size) (material)

(6) pump 1/2 8
 (HP) (yield gpm)

_____ (type power)

(7) electric log Elect.
 (yes or no)

_____ (organization running log)

(8) how well bottom plugged 4" cof.

RECEIVED


DEC 11 1974

DRILLERS REMARKS:

MISS. BD. OF WATER COMMISSIONERS

If well telescopes please sketch and show depths.

GROUND LEVEL

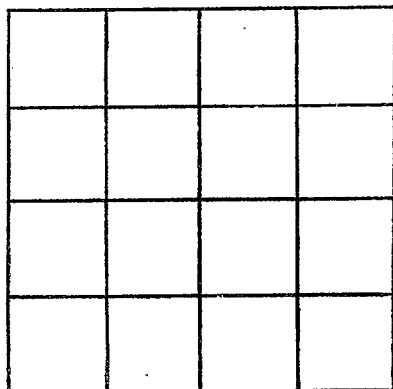

SECTION _____

Please indicate well location X.

ADDITIONAL INFORMATION

If more than one screen,
show locations of each on sketch.