

MARSHALL
 W 19
 3-4-75

MISSISSIPPI
 BOARD OF WATER COMMISSIONERS
 416 North State Street
 Jackson, Mississippi 39201

WATER WELL DRILLERS LOG

CODED

March 4 1975 J. W. Webb & Sons Marshall
 date well completed firm name county well located

LANDOWNER: J. R. Walker

description of formations encountered

from to

Potts Camp Miss.
 (mailing address)

O Soil	0	1
Bumbo Clay	1	40
Sand & Clay	40	220
Blue Rock	220	680
Hard Rock	680	700
Sand & Rocks	700	800
Pepley Sand		

WELL LOCATION:

sec. 32 T 56 N R 1 W E
 S W

_____ miles _____ of _____
 (distance) (direction) (nearest town)

WELL PURPOSE:

(home, irrigation, municipal, industrial)

WELL COMPLETION DATA:

- (1) diameter (inches) 4
- (2) total depth (feet) 800
- (3) static water level (feet) 65 below above top of ground.
- (4) casing Steel 260'
 (material) (depth)
4"
 (size) if telescope see back.
- (5) screen 0 0
 (length) (depth to top)
0 0
 (size) (material)
- (6) pump 1/2 HP 4
 (HP) (yield gpm)
Elec
 (type power)
- (7) electric log no
 (yes or no)
- _____ (organization running log)
- (8) how well bottom plugged _____

CODED


DRILLERS REMARKS:

RECEIVED
 APR 22 1975

MISS. BD. OF W.

If well telescopes please sketch and show depths.

GROUND LEVEL

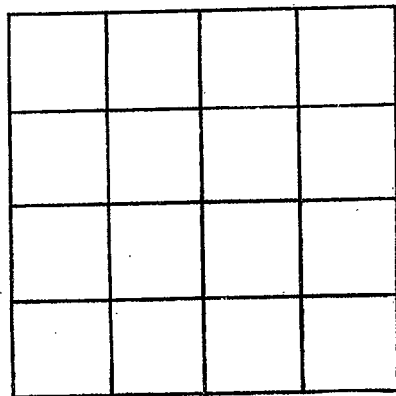

SECTION _____

Please indicate well location X.

ADDITIONAL INFORMATION

If more than one screen, show locations of each on sketch.