

Marshall
U20
7-10-75

MISSISSIPPI
BOARD OF WATER COMMISSIONERS
416 North State Street
Jackson, Mississippi 39201

WATER WELL DRILLERS LOG

July 10 1975 R. L. Carpenter Marshall
date well completed firm name county well located

LANDOWNER: Tommie Howell
Roths Camp, Miss
RFD
(mailing address)

WELL LOCATION:
sec 6 T 5 N R 1 E
2 1/2 miles Northwest of Roths Camp
(distance) (direction) (nearest town)

WELL PURPOSE: Home
(home, irrigation, municipal, industrial)

WELL COMPLETION DATA:

(1) diameter (inches) 4

(2) total depth (feet) 190

(3) static water level (feet) 100 below top of ground.

(4) casing Plastic, 160'
(material) (depth)

 If telescope see back.
(size)

(5) screen 30', 160'
(length) (depth to top)

4", Plastic
(size) (material)

(6) pump 1/2, 9
(HP) (yield gpm)

Elec.
(type power)

(7) electric log no
(yes or no)

(organization running log)


(8) how well bottom plugged Plastic cap

description of formations encountered	from	to
Surface Soil	0	15
Med Brown Sand	15	31
White Clay	31	45
Blue mud	45	110
Thay Fine Sand	110	120
Blue mud	120	132
Fine Thay Sand & Med. White sand	132	190

MISSISSIPPI
JUL 22 1975
MISS. Bd. OF WATER COMMISSIONERS

If well telescopes please sketch and show depths.

GROUND LEVEL

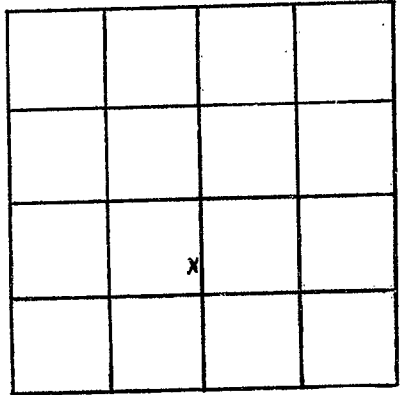

SECTION 6

Please indicate well location X.

ADDITIONAL INFORMATION

If more than one screen, show locations of each on sketch.