

MARSHALL
U 23
8-25-86

MISSISSIPPI
 BOARD OF WATER COMMISSIONERS
 416 North State Street
 Jackson, Mississippi 39201

WATER WELL DRILLERS LOG

Aug 25 1986 J.W. WEBB & SONS, INC. MARSHALL
 date well completed firm name county well located

LANDOWNER:	description of formations encountered	from	to
<u>TOWN OF POTTS CAMP</u>	<u>CLAY</u>	<u>0</u>	<u>20</u>
<u>POTTS CAMP, MS</u> (mailing address)	<u>BLUE CLAY</u> <u>SAND</u>	<u>20</u> <u>570</u>	<u>570</u> <u>635</u>
WELL LOCATION:			
sec <u>21</u> T <u>S</u> R <u>1</u> E			
S W			
<u>1</u> miles <u>EAST</u> of <u>POTTS CAMP</u>			
(distance) (direction) (nearest town)			
WELL PURPOSE: (home, irrigation, <u>municipal</u> , industrial)			
WELL COMPLETION DATA:			
(1) diameter (inches) <u>10"</u>			
(2) total depth (feet) <u>635</u>			
(3) static water level (feet) <u>2</u> <u>below</u> above top of ground.			
(4) casing <u>STEEL</u> <u>570</u> (material) (depth)			
(size) If telescope see back.			
(5) screen <u>50'</u> <u>582</u> (length) (depth to top)			
<u>6</u> <u>S.S.</u> (size) (material)			
(6) pump <u>50</u> <u>250</u> (HP) (yield gpm)			
<u>ELEC.</u> (type power)			
(7) electric log <u>YES</u> (yes or no)			
<u>STATE</u> (organization running log)			
(8) how well bottom plugged <u>BACK-WASH VALVE</u>			
DRILLERS REMARKS:			

RECEIVED
ALL


OCT 27 1986

Department of Natural Resources
 Bureau of Land & Water Resources

2/25/86

If well telescopes please sketch and show depths.

GROUND LEVEL

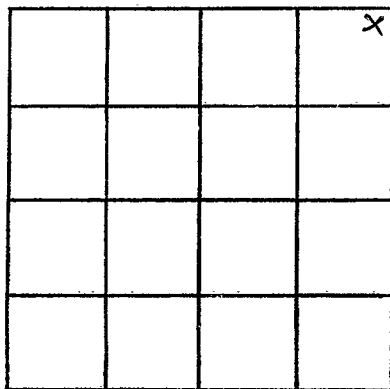

SECTION 21

Please indicate well location X.

ADDITIONAL INFORMATION

If more than one screen, show locations of each on sketch.